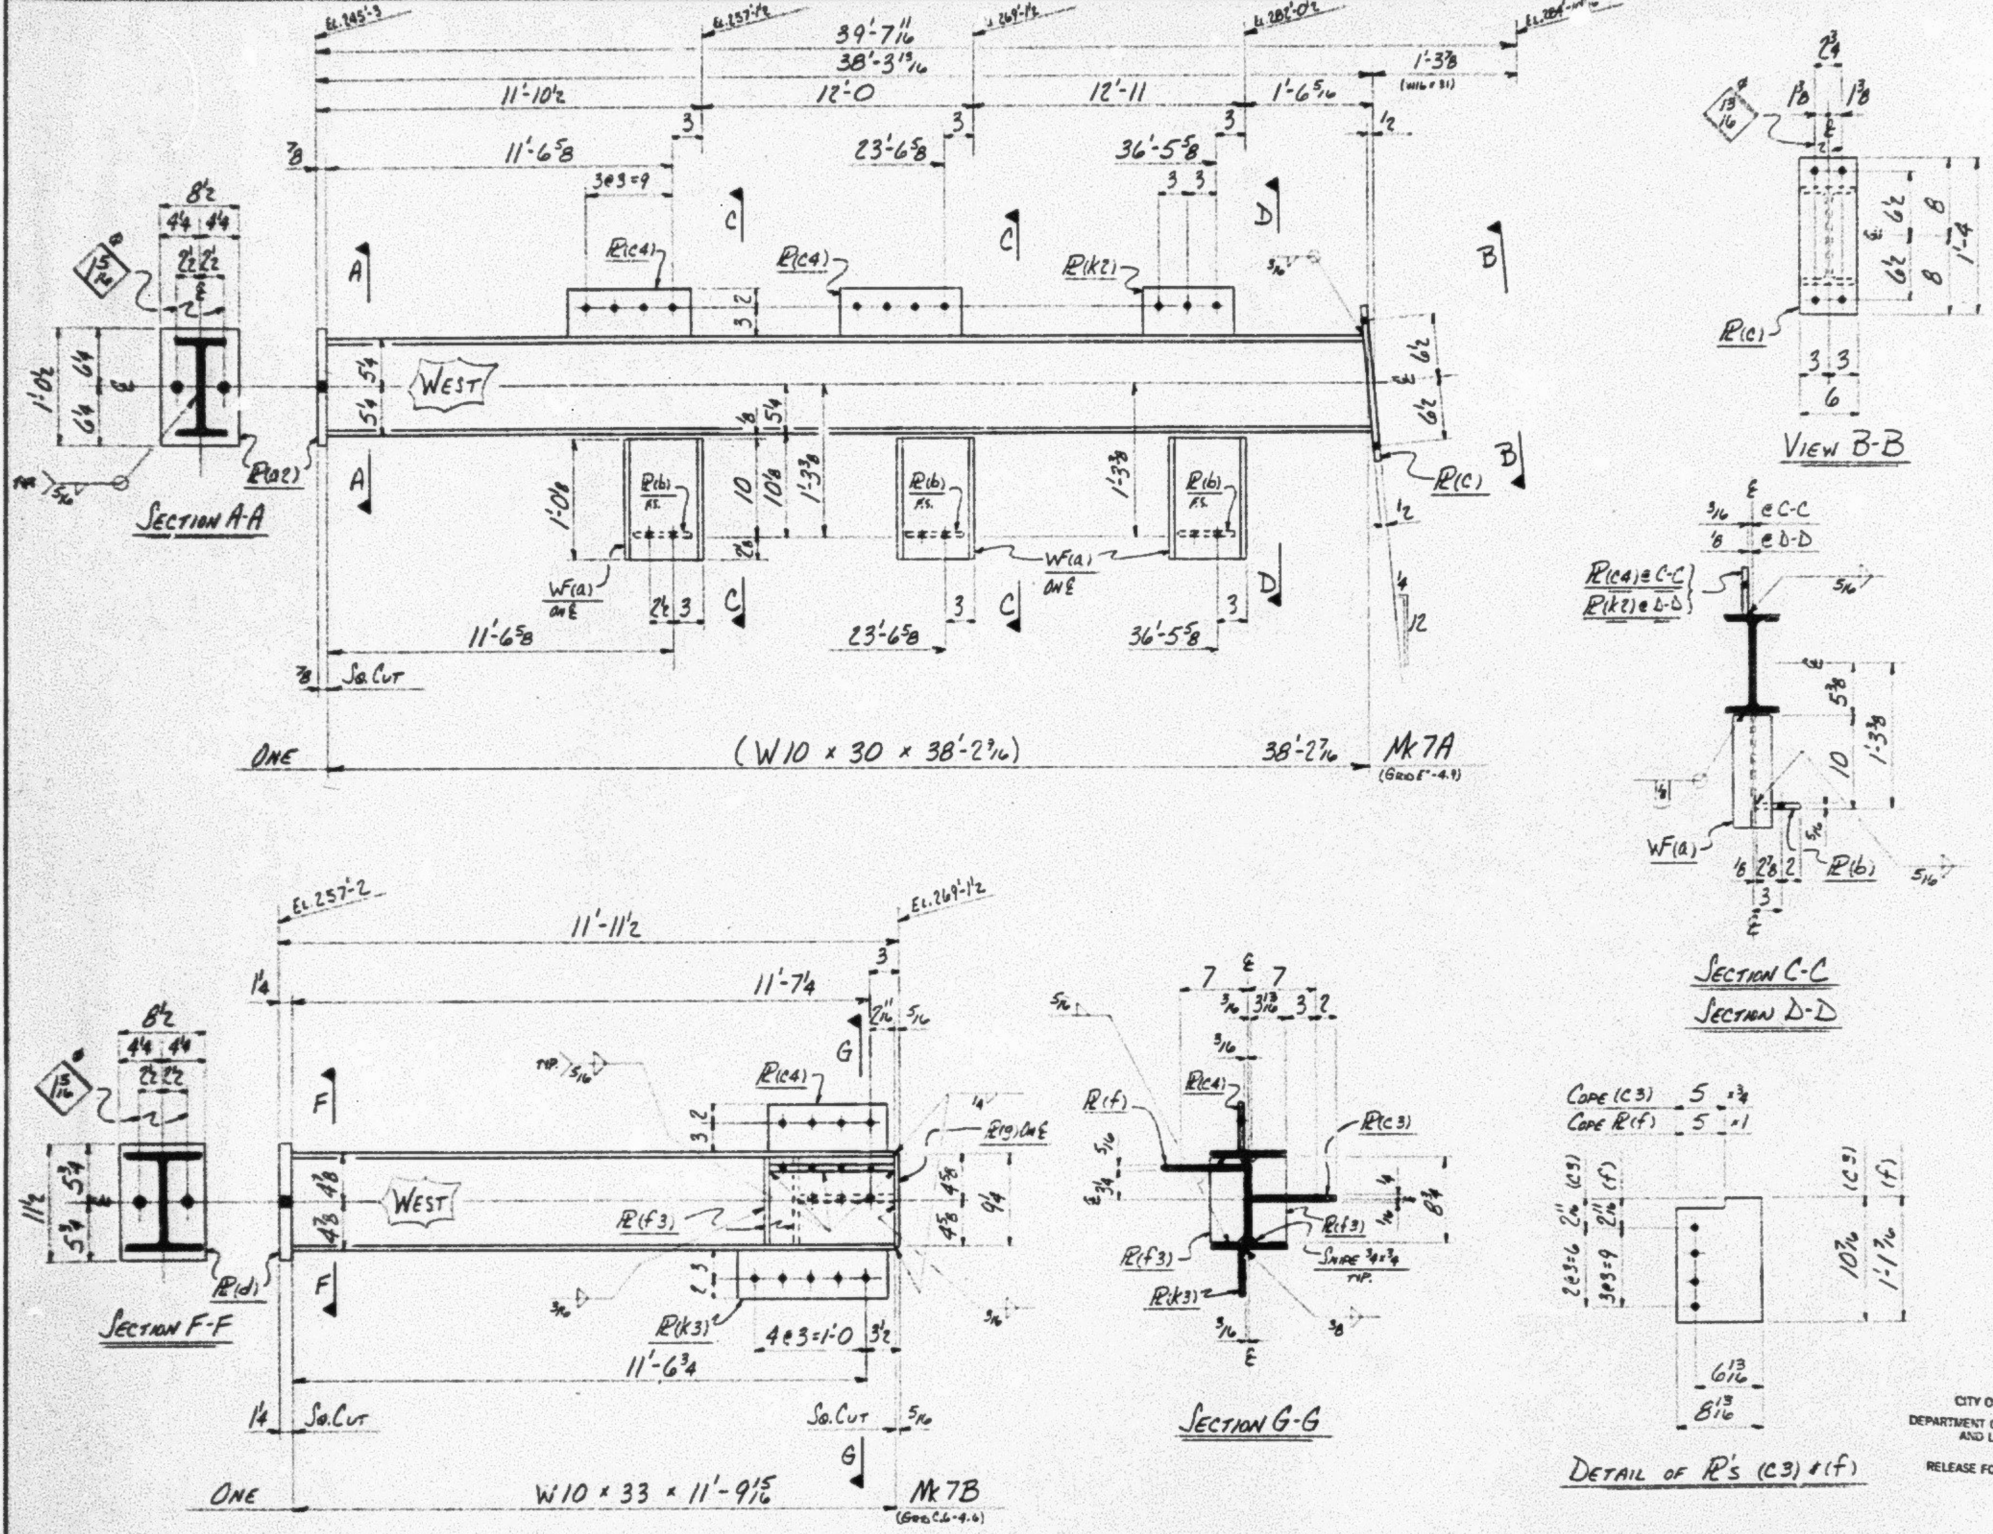
EL. 245'-3
EL. 257'-1½
EL. 269'-1½
EL. 282'-0½
EL. 284'-11½
39'-7 11/16
38'-3 13/16
11'-10½
12'-0
12'-11
1'-6 5/16
1'-3⅜
11'-6⅝
23'-6⅝
36'-5⅝
3@3=9
PL(C4)
PL(C4)
PL(K2)
WEST
PL(a2)
PL(b) F.S.
PL(C)
WF(a) ONE
Section A-A
Sq. Cut
ONE
(W10 × 30 × 38'-2 9/16)
38'-2 9/16
Mk 7A
(Grid E-4.9)
View B-B
Section C-C
Section D-D
PL(C4) @ C-C
PL(K2) @ D-D
EL. 257'-2
EL. 269'-1½
11'-11½
11'-7¼
PL(C4)
PL(f3)
PL(K3)
PL(g) ONE
4@3=1'-0
11'-6¾
Section F-F
PL(d)
Sq. Cut
ONE
W10 × 33 × 11'-9 15/16
Mk 7B
(Grid C.6-4.6)
Section G-G
PL(f)
PL(C3)
Snipe ¾ × ¾ TYP.
Cope (C3) 5 × ¾
Cope PL(f) 5 × 1
Detail of PL's (C3) & (f)
6 13/16
8 13/16
10 7/16
1'-1 7/16

CITY OF SEATTLE
DEPARTMENT OF CONSTRUCTION
AND LAND USE

RELEASE FOR INSPECTION

STANDARD STEEL FABRICATING CO., INC.
8155 - 1st Ave. So. SEATTLE, WASH. 98108

BILL OF MATERIAL

JOB NO. 7356
DWG. NO. 7
REV.

NO. OF PCS.	SHIP MARK	ASSY. MARK	MATERIAL	LENGTH FT.	LENGTH IN.	REMARKS
ONE	7A		W10 × 30	38	2 9/16	
1		a2	PL ⅞ × 8½	1	0½	
1		k2	PL 5/16 × 5	0	9½	
2		c4	PL 5/16 × 5	1	0½	
3		a	W8 × 10	1	0⅛	
3		b	PL 5/16 × 4⅞	0	6	
1		c	PL ½ × 6	1	4	
ONE	7B		W10 × 33	11	9 15/16	
1		d	PL 1¼ × 8½	0	11½	
1		f	PL 5/16 × 8 13/16	1	1 7/16	
1		c3	PL 5/16 × 8 13/16	0	10 7/16	
2		f3	PL 5/16 × 3 13/16	0	8¾	
1		g	PL 5/16 × 8	0	9¼	
1		k3	PL ⅜ × 5	1	3½	
1		c4				

RECEIVED
AUG 16 1985
DEPT. OF CONSTRUCTION & LAND USE

APPROVED
WITH CORRECTIONS NOTED
THIS APPROVAL DOES NOT RELIEVE
THE SUBCONTRACTOR OR MATERIAL
SUPPLIER FROM RESPONSIBILITY FOR
ERRORS OR DEVIATIONS FROM DRAWINGS
AND SPECIFICATIONS
SELLEN CONSTRUCTION CO., INC.
GENERAL CONTRACTOR
By EB Date 8-15-85

RECEIVED
KPFF - SEATTLE
DIST.
AUG 9 1985
FILE

X CONFORMS TO DESIGN CONCEPT
CONFORMANCE TO DESIGN CONCEPT WITH
REVISIONS AS SHOWN
[illegible]
D Wagner 8/13/85
kpff

APPROVAL STAMPS	INSPECTION	
	BY:	
	WELDING:	
	TESTING: VISUAL - MP - US - XR	
	STAMPED DWGS.	

STANDARD STEEL FABRICATING CO., INC.
8155 - 1st Ave. So. SEATTLE, WASH. 98108
Phone (206) 762-2014

HOLES 11/16 Ø EXCEPT AS NOTED
BOLT DIA. ¾ EXCEPT AS NOTED
PAINT: No Paint
DR. BY Ellipse
DATE
CHK. BY
DATE

NO.	DATE	BY	REVISION

JOB Seattle Kero Nursing Home
LOCATION Seattle, WA
CONTRACTOR Sellen Constr Co.

Column Details

JOB NO. 7356
DWG. NO. 7
REV.

PRINT RECORD

NO.	ISS.	DATE
5	APPL.	8/5
	APPL.	
	SHOP	
	SHOP	

NOTE: If the microfilmed drawing is LESS clear than this notice, it is due to the

24X

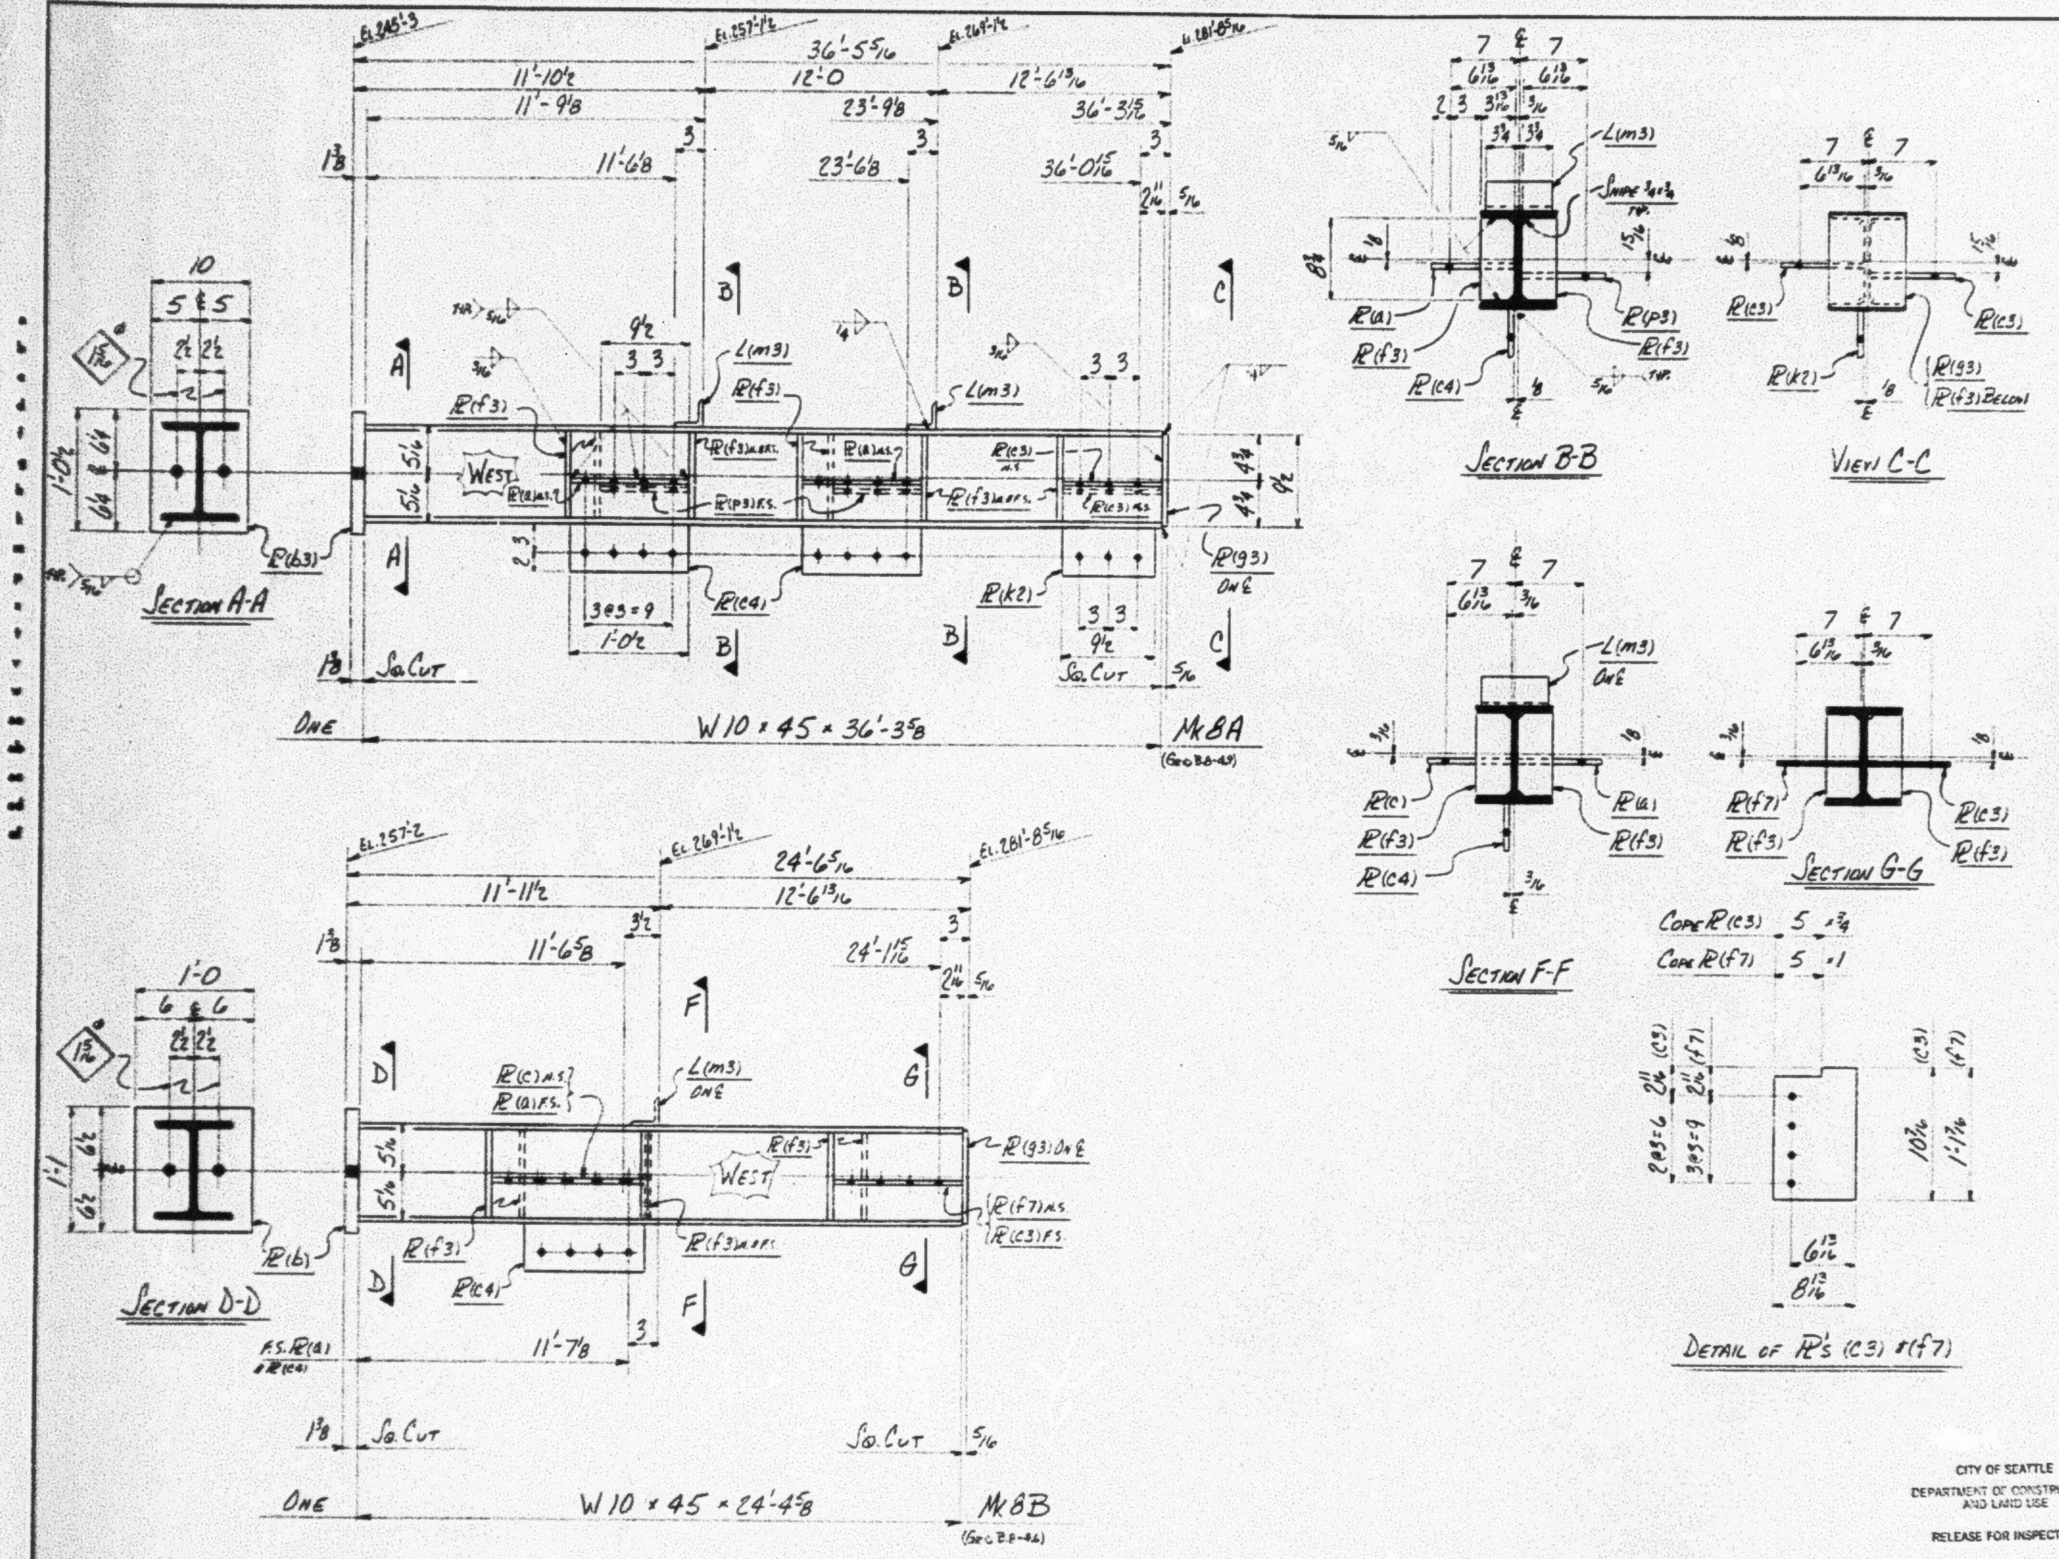
EL. 245'-9
EL. 257'-1 1/2
EL. 269'-1 1/2
EL. 281'-8 5/16
36'-5 5/16
11'-10 1/2
12'-0
12'-6 13/16
11'-9 1/8
23'-9 1/8
36'-3 1/2
11'-6 1/8
23'-6 1/8
36'-0 1/16
WEST
SECTION A-A
SQ. CUT
ONE
W10 × 45 × 36'-3 5/8
Mk 8A
SECTION B-B
VIEW C-C
SECTION F-F
SECTION G-G
EL. 257'-2
EL. 269'-1 1/2
EL. 281'-8 5/16
24'-6 5/16
11'-11 1/2
12'-6 13/16
11'-6 5/8
24'-1 1/16
11'-7 1/8
WEST
SECTION D-D
SQ. CUT
ONE
W10 × 45 × 24'-4 5/8
Mk 8B
COPE PL(c3) 5 × 3/4
COPE PL(f7) 5 × 1
DETAIL OF PL'S (c3) & (f7)

STANDARD STEEL FABRICATING CO., INC.
8165 - 1st Ave. So. SEATTLE, WASH. 98108

JOB NO. 7356
DWG. NO. 8
REV.

BILL OF MATERIAL

NO. OF PCS.	SHIP MARK	ASSY. MARK	MATERIAL	LENGTH FT.	LENGTH IN.	REMARKS
ONE	8A		W10 × 45	36	3 5/8	
1		b3	PL 1 3/8 × 10	1	0 1/2	
2		a	PL 5/16 × 8 13/16	1	0 1/2	
2		p3	PL 5/16 × 8 13/16	0	9 1/2	
2		c3	PL 5/16 × 8 13/16	0	10 7/16	
10		f3	PL 5/16 × 3 13/16	0	8 3/4	
1		g3	PL 5/16 × 8	0	9 1/2	
2		c4	PL 5/16 × 5	1	2 1/2	
1		k2	PL 5/16 × 5	0	9 1/2	
2		m3	L3 × 3 × 1/4	0	7 1/2	
ONE	8B		W10 × 45	24	4 5/8	
1		b	PL 1 3/8 × 12	1	1	
1		c	PL 3/8 × 8 13/16	1	3 1/2	
1		a				
1		f7	PL 5/16 × 8 13/16	1	1 7/16	
1		c3				
1		g3				
6		f3				
1		m3				
1		c4				

RECEIVED
AUG 19 1996
DEPT. OF CONSTRUCTION & LAND USE

APPROVED
WITH CORRECTIONS NOTED
THIS APPROVAL DOES NOT RELIEVE THE SUBCONTRACTOR OR MATERIAL SUPPLIER FROM RESPONSIBILITY FOR ERRORS OR DEVIATIONS FROM DRAWINGS AND SPECIFICATIONS
SELLEN CONSTRUCTION CO., INC.
GENERAL CONTRACTOR
By EB Date [illegible]

CITY OF SEATTLE
DEPARTMENT OF CONSTRUCTION AND LAND USE
RELEASE FOR INSPECTION

RECEIVED
KPFF - SEATTLE
AUG 6 1996
FILE

X CONFORMS TO DESIGN CONCEPT
☐ CONFORMS TO DESIGN CONCEPT WITH REVISIONS AS SHOWN
☐ NON-CONFORMING-REVISE & RESUBMIT
[illegible]
D Wagner [illegible]
kpff

APPROVAL STAMPS	INSPECTION	
	BY:	
	WELDING:	
	TESTING: VISUAL - [illegible]	
	STAMPED DWGS.	

STANDARD STEEL FABRICATING CO., INC.
8165 - 1st Ave. So. SEATTLE, WASH. 98108
Phone (206) 763-2934

HOLES 1 1/16" EXCEPT AS NOTED
EDGE DIST. 1 1/4" EXCEPT AS NOTED
PAINT No PAINT
DR. BY Edwards
JOB SEATTLE KEIRO NURSING HOME
LOCATION SEATTLE WA.
CONTRACTOR SELLEN CONSTR. CO.

COLUMN DETAILS

JOB NO. 7356
DWG. NO. 8

NO.	BY	DATE
8	APPR.	9/5

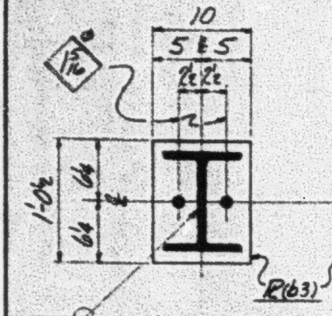
10
5 5
2 1/2 2 1/2
1'-0 1/2
6 1/4
6 1/4
1 3/8
PL(b3)
5/16

SECTION A-A

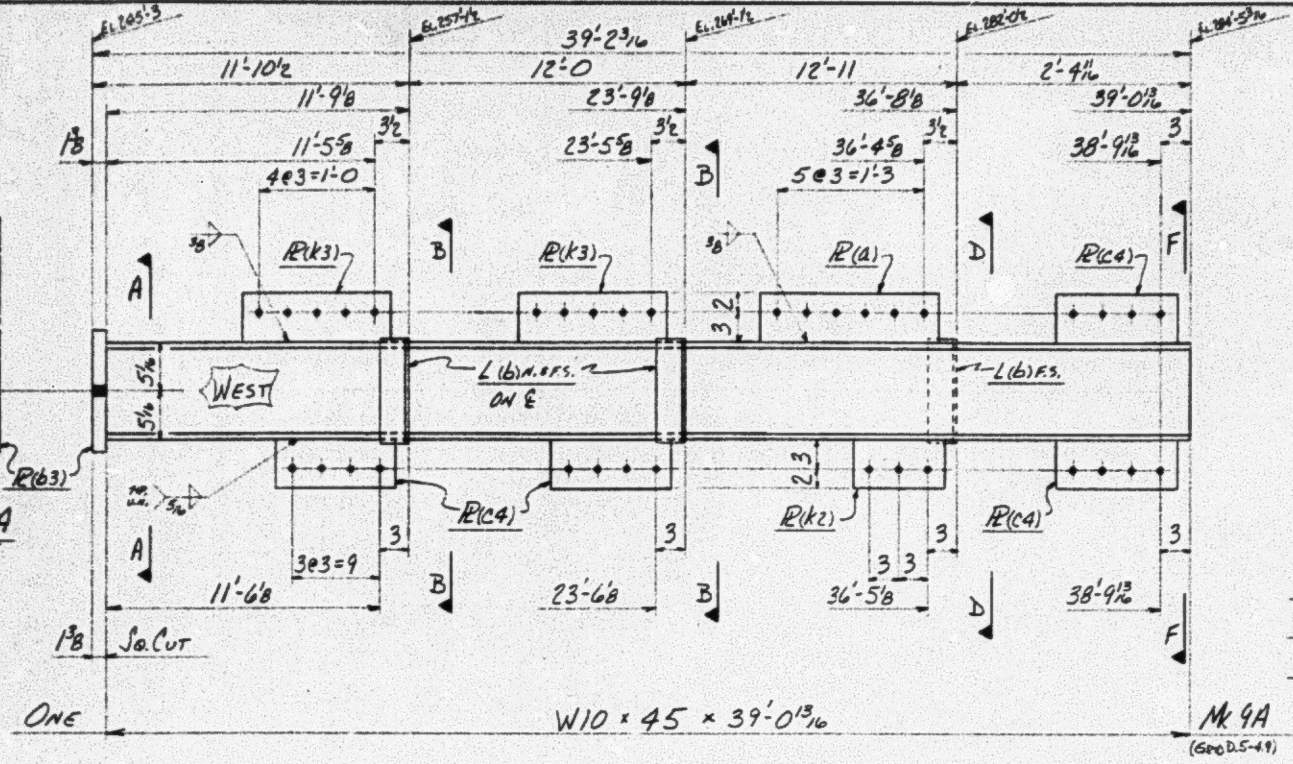
EL 245'-3
EL 257'-1 1/2
EL 269'-1 1/2
EL 282'-0 1/2
EL 284'-5 3/16
39'-2 3/16
11'-10 1/2
12'-0
12'-11
2'-4 11/16
11'-9 1/8
23'-9 1/8
36'-8 1/8
39'-0 13/16
1 3/8
11'-5 5/8
23'-5 5/8
36'-4 5/8
38'-9 13/16
3 1/2
3
4@3=1'-0
5@3=1'-3
PL(k3)
PL(k3)
PL(a)
PL(C4)
3/8
A
B
D
F
WEST
5 1/16
L(b) N.F.S. ON ℄
L(b) F.S.
PL(b3)
PL(C4)
PL(k2)
PL(C4)
3@3=9
11'-6 1/8
23'-6 1/8
36'-5 1/8
38'-9 13/16
1 3/8
SQ. CUT
ONE
W10 × 45 × 39'-0 13/16
Mk 9A
(Grid D.5-4.9)

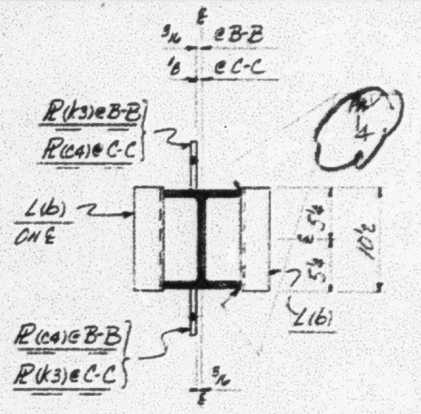
℄
3/16 @B-B
1/8 @C-C
PL(k3)@B-B
PL(C4)@C-C
L(b) ONE
5 1/4
5 1/4
10 1/2
L(b)
PL(C4)@B-B
PL(k3)@C-C
5/16
4

SECTION B-B

SECTION C-C

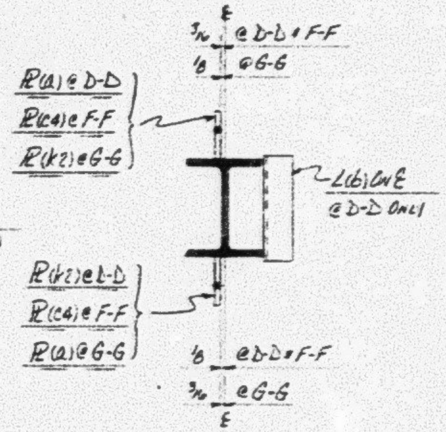
℄
3/16 @D-D & F-F
1/8 @G-G
PL(a)@D-D
PL(C4)@F-F
PL(k2)@G-G
L(b) ONE @D-D ONLY
PL(k2)@D-D
PL(C4)@F-F
PL(a)@G-G
1/8 @D-D & F-F
3/16 @G-G

SECTION D-D

SECTION F-F

SECTION G-G

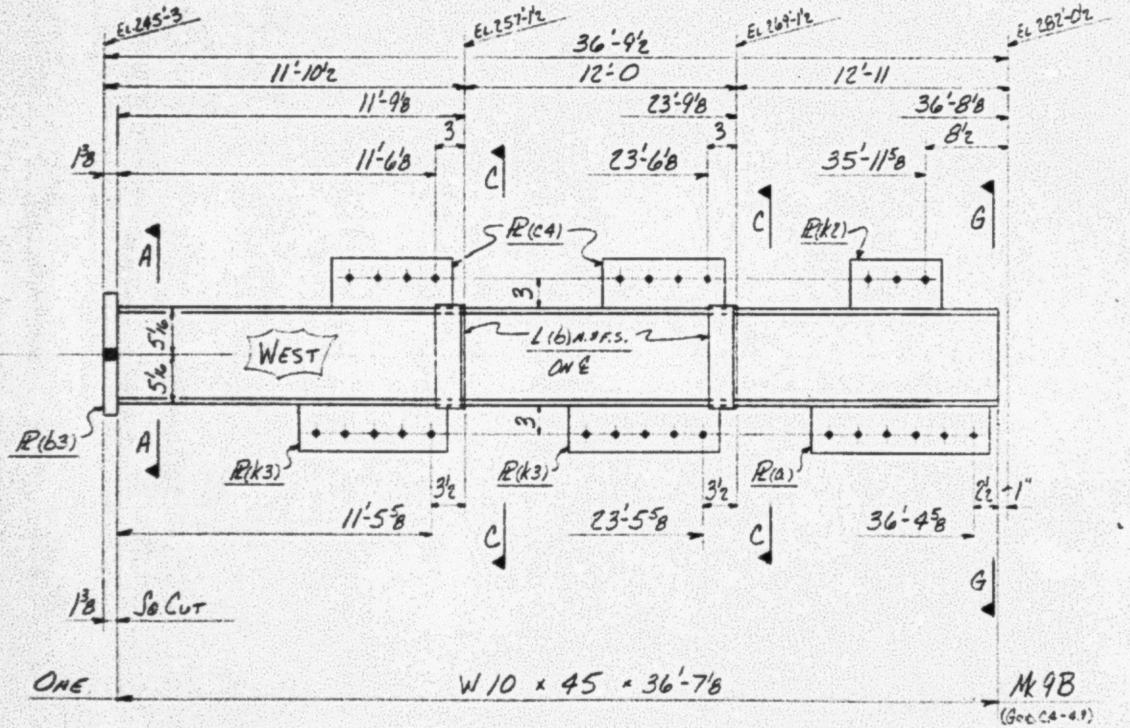
EL 245'-3
EL 257'-1 1/2
EL 269'-1 1/2
EL 282'-0 1/2
36'-9 1/2
11'-10 1/2
12'-0
12'-11
11'-9 1/8
23'-9 1/8
36'-8 1/8
1 3/8
3
11'-6 1/8
23'-6 1/8
35'-11 5/8
8 1/2
C
G
A
PL(C4)
PL(k2)
3
WEST
5 1/16
L(b) N.F.S. ON ℄
PL(b3)
PL(k3)
PL(k3)
PL(a)
3 1/2
2 1/2
1"
11'-5 5/8
23'-5 5/8
36'-4 5/8
1 3/8
SQ. CUT
ONE
W10 × 45 × 36'-7 1/8
Mk 9B
(Grid C.4-4.9)

STANDARD STEEL FABRICATING CO., INC.
SEATTLE, WASH.
JOB NO. 7356
DWG. NO. 9
REV.

BILL OF MATERIAL

NO. OF PCS.	SHIP MARK	ASSY. MARK	MATERIAL	LENGTH FT.	LENGTH IN.	REMARKS
ONE	9A		W10×45	39	0 13/16	
1		b3	PL 1 3/8 × 10	1	0 1/2	
4		C4	PL 5/16 × 5	1	0 1/2	
1		k2	PL 5/16 × 5	0	9 1/2	
2		k3	PL 3/8 × 5	1	3 1/2	
1		a	PL 3/8 × 5	1	6 1/2	
5		b	L3×3×1/4	0	10 1/2	
ONE	9B		W10×45	36	7 1/8	
1		b3				
2		C4				
1		k2				
2		k3				
1		a				
4		b				

RECEIVED
AUG 15 1986
DEPT. OF CONSTRUCTION & LAND USE

APPROVED
WITH CORRECTIONS NOTED
THIS APPROVAL DOES NOT RELIEVE
THE SUBCONTRACTOR OR MATERIAL
SUPPLIER FROM RESPONSIBILITY FOR
ERRORS OR DEVIATIONS FROM DRAWINGS
AND SPECIFICATIONS
SELLEN CONSTRUCTION CO., INC.
GENERAL CONTRACTOR
By EB Date 8-15-86

CITY OF SEATTLE
DEPARTMENT OF CONSTRUCTION
AND LAND USE
RELEASE FOR INSPECTION

RECEIVED
KPFF - SEATTLE
AUG 6 1986
FILE

☐ CONFORMS TO DESIGN CONCEPT
X CONFORMS TO DESIGN CONCEPT WITH REVISIONS AS SHOWN
☐ NON-CONFORMING-REVISE & RESUBMIT
[illegible]
By D.L. Wagner 8/3/86
KPFF

APPROVAL STAMPS	INSPECTION	
	BY	
	WELDING	
	TESTING: VISUAL, MP, UT	
	STAMPED DWGS.	

STANDARD STEEL FABRICATING CO., INC.
SEATTLE, WASH.

HOLES 11/16" EXCEPT AS NOTED
BOLT SIZE 5/8" EXCEPT AS NOTED
PAINT No PAINT
DR. BY ECLASSE
DATE
CHK. BY
DATE
NO. DATE BY REVISION

JOB Seattle Keiro Nursing Home
LOCATION Seattle, WA.
CONTRACTOR Sellen Constr. Co.

COLUMN DETAILS

JOB NO. 7356
DWG. NO. 9
REV.

NO.	FOR	DATE
8	APPR.	8/5
	APPR.	
	APPR.	
	SHOP	
	SHOP	
	SHOP	

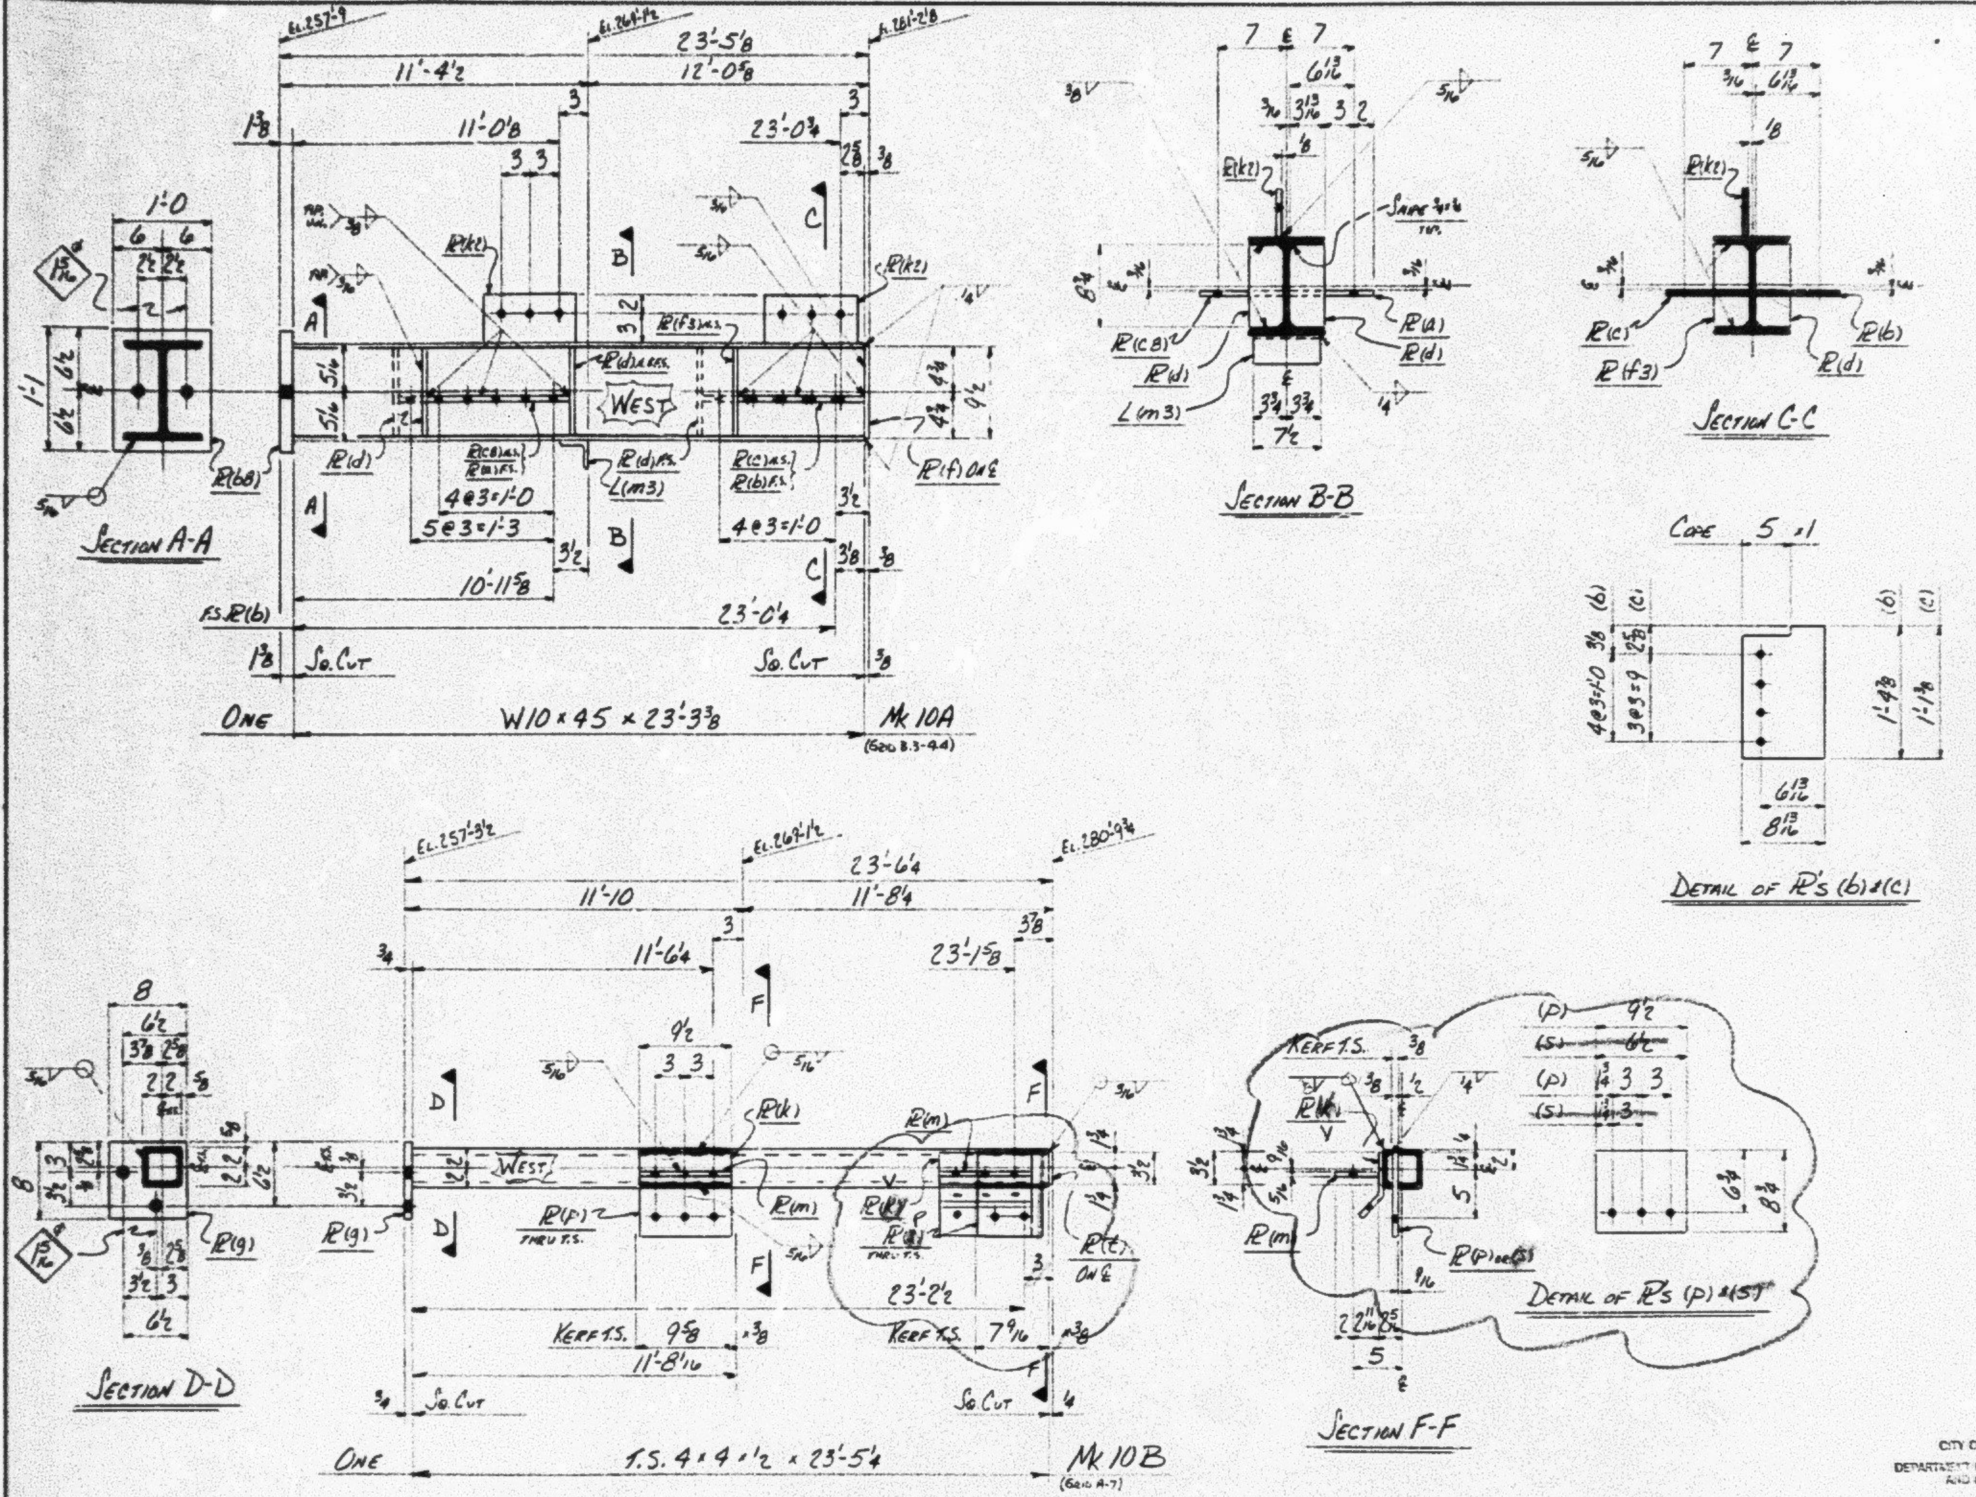
EL. 257'-9
EL. 264'-1 1/2
EL. 281'-2 1/8
23'-5 1/8
11'-4 1/2
12'-0 5/8
11'-0 1/8
23'-0 3/4
1'-0
PL(k2)
PL(f3)A.S.
PL(d)A.S.F.S.
WEST
PL(CB)A.S.
PL(m)F.S.
PL(d)F.S.
L(m3)
PL(c)A.S.
PL(b)F.S.
PL(f) ONE
PL(bB)
4@3=1'-0
5@3=1'-3
10'-11 5/8
23'-0 1/4
F.S. PL(b)
SQ. CUT
ONE
W10 x 45 x 23'-3 3/8
Mk 10A
(Grid B.3-4.4)
SECTION A-A
SECTION B-B
SECTION C-C
SNIPE 3/4 x 3/4 TYP.
COPE 5 x 1
DETAIL OF PL'S (b) & (c)
EL. 257'-3 1/2
EL. 269'-1 1/2
EL. 280'-9 3/4
23'-6 1/4
11'-10
11'-8 1/4
11'-6 1/4
23'-1 5/8
23'-2 1/2
PL(k)
PL(m)
PL(p) THRU T.S.
PL(g)
PL(t) ONE
KERF T.S.
11'-8 1/16
ONE
T.S. 4 x 4 x 1/2 x 23'-5 1/4
Mk 10B
(Grid A-7)
SECTION D-D
SECTION F-F
DETAIL OF PL'S (p) & (s)

STANDARD STEEL FABRICATING CO., INC.
8135 - 1st Ave. So. SEATTLE, WASH. 98108

JOB NO. 7356
DWG. NO. 10
REV.

BILL OF MATERIAL

NO. OF PCS.	SHIP MARK	ASSY. MARK	MATERIAL	LENGTH FT.	LENGTH IN.	REMARKS
ONE	10A		W10 x 45	23	3 3/8	
1		bB	PL 1 3/8 x 12	1	1	
1		cB	PL 3/8 x 8 13/16	1	3 1/2	
1		a	PL 3/8 x 8 13/16	1	6 1/2	
1		b	PL 3/8 x 8 13/16	1	4 7/8	
1		c	PL 5/16 x 8 13/16	1	1 3/8	
5		d	PL 3/8 x 3 13/16	0	8 3/4	
1		f3	PL 5/16 x 3 13/16	0	8 3/4	
1		f	PL 3/8 x 8	0	9 1/2	
2		k2	PL 5/16 x 5	0	9 1/2	
1		m3	L 3 x 3 x 1/4	0	7 1/2	
ONE	10B		T.S. 4 x 4 x 1/2	23	5 1/4	
1		g	PL 3/4 x 8	0	8	
~~2~~ 1		k	PL 5/16 x 3 1/2	0	9 1/2	
2		m	PL 5/16 x 4 11/16	0	9 1/2	
1		p	PL 5/16 x 8 3/4	0	9 1/2	
~~1~~		~~s~~	~~PL 5/16 x 6 1/2~~	~~0~~	~~8 3/4~~	
1		t	PL 1/4 x 3 1/2	0	3 1/2	
1		v	BENT PL 3/8	0	9 1/2	

RECEIVED
AUG 16 1985
DEPT. OF CONSTRUCTION & LAND USE
LAND USE DIVISION

APPROVED
WITH CORRECTIONS NOTED
THIS APPROVAL DOES NOT RELIEVE
THE SUBCONTRACTOR OR MATERIAL
SUPPLIER FROM RESPONSIBILITY FOR
ERRORS OR OMISSIONS FROM DRAWINGS
AND SPECIFICATIONS
SELLEN CONSTRUCTION CO., INC.
GENERAL CONTRACTOR
By EB Date 8-5-86

CITY OF SEATTLE
DEPARTMENT OF CONSTRUCTION
AND LAND USE
RELEASE FOR INSPECTION

RECEIVED
KPFF - SEATTLE
AUG 6 1986
FILE

☐ CONFORMS TO DESIGN CONCEPT
☐ CONFORMS TO DESIGN CONCEPT WITH REVISIONS AS SHOWN
☒ NON-CONFORMING-REVISE AND RESUBMIT
[illegible]
DWagner 8/13/86
KPFF

APPROVAL STAMPS	INSPECTION	
	BY	
	WELDING	
	TESTING, VISUAL - AP - UB - XR	
	STAMPED DWGS.	

STANDARD STEEL FABRICATING CO., INC.
8135 - 1st Ave. So. SEATTLE, WASH. 98108
Phone (206) 767-2514

HOLES 1 1/16" EXCEPT AS NOTED
EDGE DIST. 1 1/4" EXCEPT AS NOTED
PAINT NO PAINT
DR. BY ECLARK
DATE
CHK. BY
DATE

JOB SEATTLE KERO NURSING HOME
LOCATION SEATTLE, WA
CONTRACTOR SELLEN CONSTR. CO.

COLUMN DETAILS

NO.	DATE	BY	REVISION

PRINT RECORD: 8 APR. 4/5

JOB NO. 7356
DWG. NO. 10
REV.

NOTE: If the microfilmed drawing is LESS clear than this notice, it is due to the

24X

28

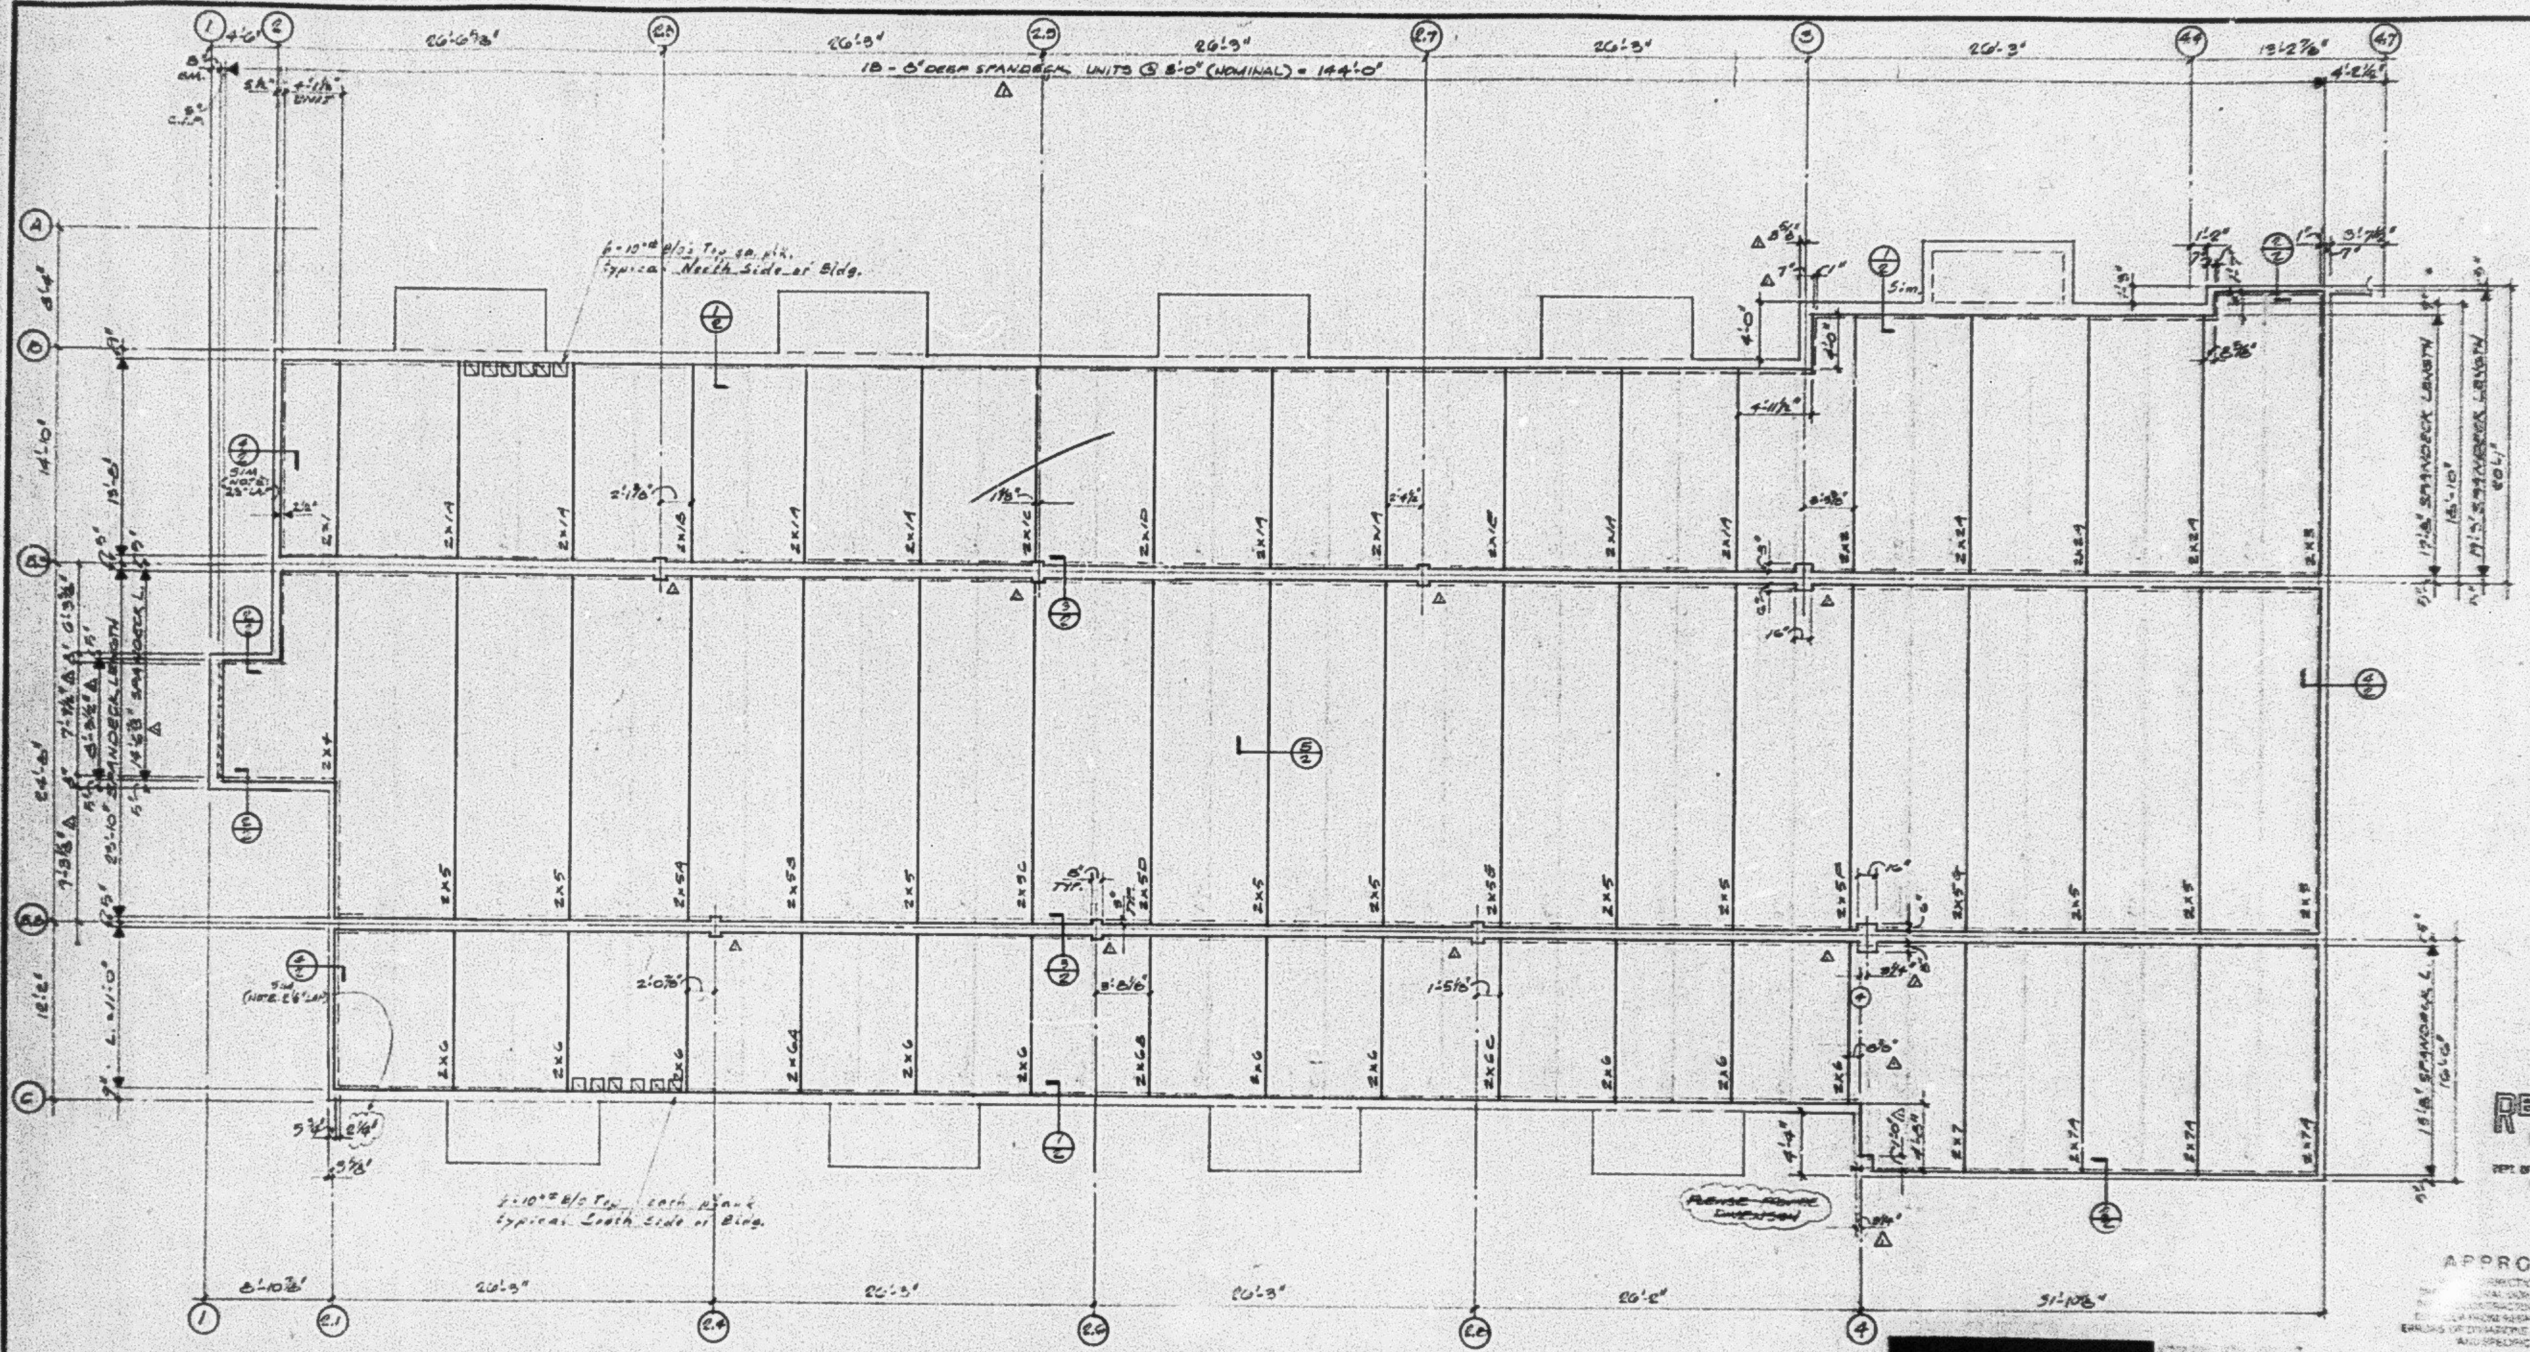

18 - 8" DEEP SPANDECK UNITS @ 8'-0" (NOMINAL) = 144'-0"
26'-6 3/8"
26'-3"
26'-3"
26'-3"
26'-3"
13'-2 7/8"
4'-2 1/2"
6"-10" E/O Top ea. plk. typical North Side of Bldg.
6"-10" E/O Top each plank typical South Side of Bldg.
Please Note Dimension
17'-8" SPANDECK LENGTH
18'-10"
19'-5" SPANDECK LENGTH
13'-8" SPANDECK L.
16'-6"
8'-10 3/8"
26'-3"
26'-3"
26'-3"
26'-2"
31'-10 3/8"
2x17
2x18
2x5
2x6
2x24
2x7

FLOOR PLAN △

SCALE: 3/32" = 1'-0"

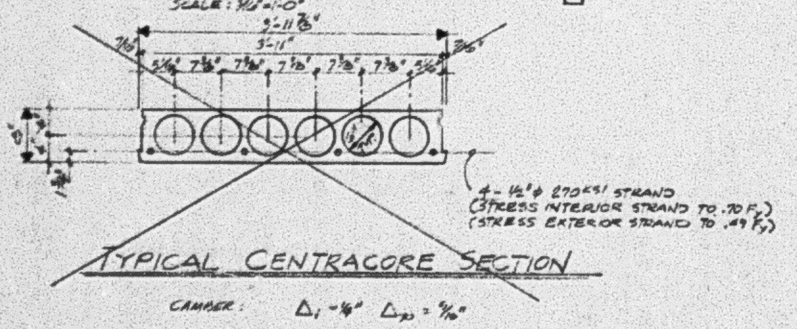

3'-11 3/8"
3'-11"
4 - 1/2" ⌀ 270KSI STRAND
(STRESS INTERIOR STRAND TO .70 Fu)
(STRESS EXTERIOR STRAND TO .49 Fu)

TYPICAL CENTRACORE SECTION

CAMBER: $\Delta_i = 1/4"$ $\Delta_\infty = 9/16"$

☒ CONFORMS TO DESIGN CONCEPT
☐ CONFORMS TO DESIGN CONCEPT WITH REVISIONS AS SHOWN
☐ NON-CONFORMING-REVISE & RESUBMIT
THIS SHOP DRAWING HAS BEEN REVIEWED FOR GENERAL CONFORMANCE WITH DESIGN CONCEPT ONLY AND DOES NOT RELIEVE THE SUBCONTRACTOR OF RESPONSIBILITY FOR CONFORMANCE WITH DESIGN DRAWINGS AND SPECIFICATIONS WHICH HAVE PRIORITY OVER THIS SHOP DRAWING
By PC Date 9-15-86
kpff

CITY OF SEATTLE
DEPT. OF CONSTRUCTION AND LAND USE
SEP 22 1986
APPROVED Subject to Errors and Omissions
By Sai P. Wong
#625411

3) BEARING SURFACE MUST BE SMOOTH AND LEVEL

RECEIVED
SEP 16 1986
DEPT. OF CONSTRUCTION & LAND USE
LAND USE DIVISION

APPROVED
CORRECTIONS NOTED
ERRORS OF DIVERGENCE FROM DRAWINGS AND SPECIFICATIONS
KELLER CONSTRUCTION CO. INC
GENERAL CONTRACTOR
By GB Date 9-10-86
NOTE BLOCKOUT REQUIRED ON SUBMITTAL OF 8-27-86

Do Not Manufacture
Without City of Seattle
Bldg. Dept. Approval

SEP 0 2 1986

F/W 1601 E. Yesler 2 #625411

JOB # 06-71 KEIRO NURSING HOME
ERECTION PLAN, NOTES

SPAN-DECK
CENTRAL PRE-MIX
CONCRETE CO.
P.O. BOX 510 KENT, WA. 98031

△	CHANGES PER CITY OF SEATTLE REQUIREMENTS & CONTR. INFO	8-25-86	CK
△	REVISIONS	DATE	CHECKED

DRAWN	CHKD
KT	MLP
DATE 7-28-86	
DWG. NO. 106-21	1/2

OTE: If the microfilmed drawing is less clear than this

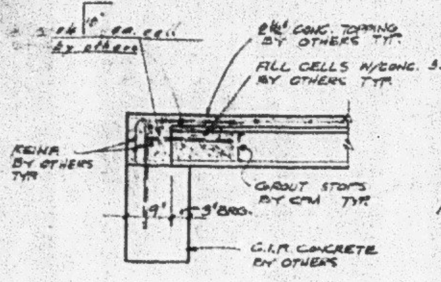
18"
18"
#4 ea. cell by others
2½" CONC. TOPPING BY OTHERS TYP.
FILL CELLS W/CONC. 3500 psi BY OTHERS TYP.
REINF. BY OTHERS TYP.
GROUT STOPS BY CPM TYP.
9"
3" BRG.
C.I.P. CONCRETE BY OTHERS

SECTION ①/②
SCALE: ¾"=1'-0"

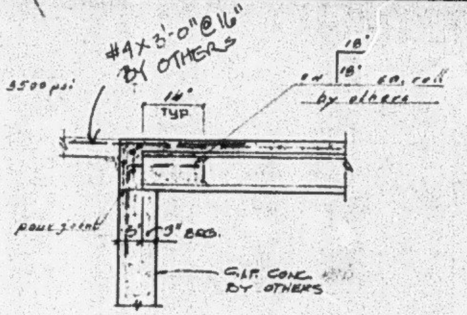
#4 x 3'-0" @16" BY OTHERS
18"
18"
#4 ea. cell by others
16"
TYP
pour joint
5"
3" BRG.
C.I.P. CONC. BY OTHERS

SECTION ②/②
SCALE: ¾"=1'-0"

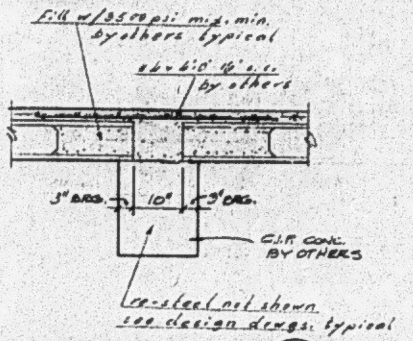
Fill w/3500 psi mix. min. by others typical
#4 x 4'-0" 16" o.c. by others
3" BRG.
10"
3" BRG.
C.I.P. CONC. BY OTHERS
re-steel not shown see design drwgs. typical

SECTION ③/②
SCALE: ¾"=1'-0"

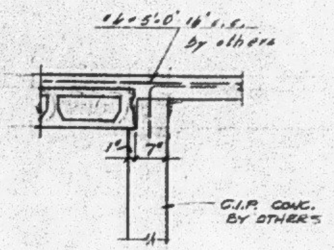
#4 x 5'-0" 16" o.c. by others
1"
7"
C.I.P. CONC. BY OTHERS

SECTION ④/②
SCALE: ¾"=1'-0"

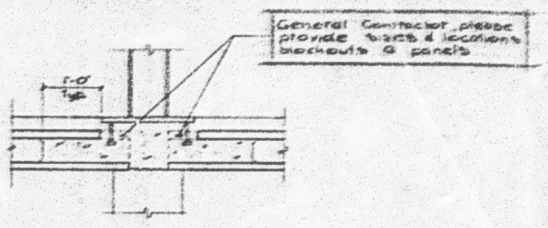
1'-0" Typ.
General Contractor, please provide sizes & locations blockouts @ panels

CONNECTION BASE PLATE TO PANEL

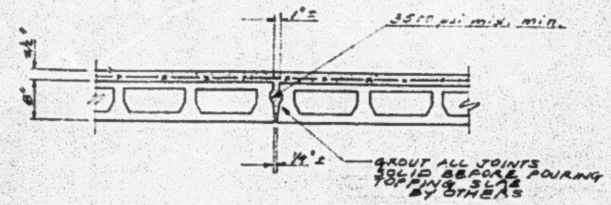
1"±
3500 psi mix. min.
2½"
8"
¼"±
GROUT ALL JOINTS SOLID BEFORE POURING TOPPING SLAB BY OTHERS

SECTION ⑤/②
SCALE: ¾"=1'-0"

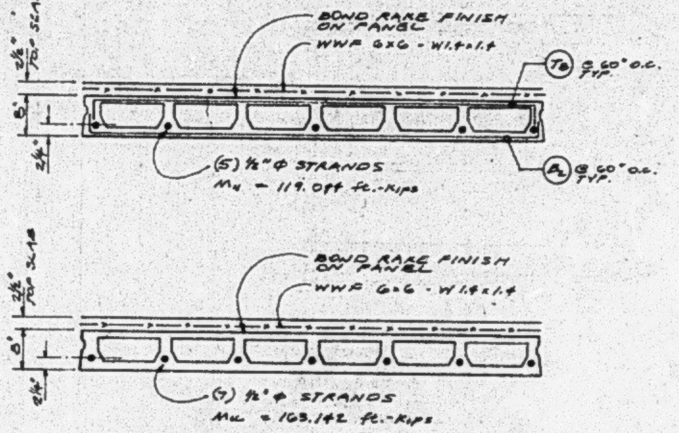
2½" TOP. SLAB
BOND RAKE FINISH ON PANEL
WWF 6x6 - W1.4x1.4
Tb @ 60" o.c. TYP.
8"
2¼"
(5) ½"φ STRANDS
Mu = 119.094 ft.-Kips
Bb @ 60" o.c. TYP.
2½" TOP. SLAB
BOND RAKE FINISH ON PANEL
WWF 6x6 - W1.4x1.4
8"
2¼"
(7) ½"φ STRANDS
Mu = 163.142 ft.-Kips

PANEL CROSS-SECTIONS △1

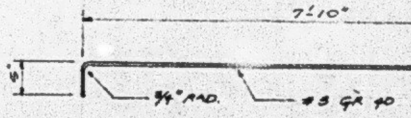
7'-10"
5"
¾" RAD.
#3 GR 40

TOP REINFORCEMENT Tb

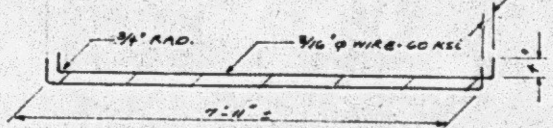
¾" RAD.
5/16"φ WIRE - 60 KSI
7'-11"±

BOTTOM REINFORCMENT Bb

STRUCTURAL NOTES △1

DESIGN LOADS:

LIVE LOADS: 40 PSF RESIDENTIAL
100 PSF CORRIDOR
DEAD LOADS: 55 PSF P.C. PANEL
31 PSF TOPPING SLAB
PARTITION LOAD: 20 PSF

TOPPING SLAB: 3000 PSI (PER DESIGN DRAWINGS).

SPANDECK MATERIAL SPEC.:

CONCRETE: 3500 PSI F'ci (@ STRESS TRANSFER).
5000 PSI F'c (@ 28 DAYS).
STRAND: UNCOATED 7-WIRE STRESS RELIEVED, ½"φ, 270 KSI, ASTM A-416
TRANSVERSE REINFORCEMENT: TOP - PER ASTM A-416 Tb
BOTTOM - A-82 WIRE, 60 KSI Bb
GROUT: 3500 PSI MIN. @ PANEL JOINTS & ENDS
RESTRAINED END CONDITION - REF. ASTM E 119
RESTRAINED ASSEMBLY - 4 HOUR FIRE RATING
U.L. DESIGN NO. J915

OK for 3 HR. per the approved code change in 1988. E.W.

CITY OF SEATTLE
DEPT. OF CONSTRUCTION AND LAND USE
SEP 22 1986
APPROVED Subject to Errors and Omissions
Sue P. Wong
By E625411

☐ CONFORMS TO DESIGN CONCEPT
☒ CONFORMS TO DESIGN CONCEPT WITH REVISIONS AS SHOWN
☐ NON-CONFORMING - REVISE & RESUBMIT
[illegible]
By PC Date 9-15-86
kpff

RECEIVED
SEP 16 1986
DEPT. OF CONSTRUCTION & LAND USE
LAND USE DIVISION

APPROVED
WITH CORRECTIONS NOTED
THIS APPROVAL DOES NOT RELIEVE THE SUBCONTRACTOR OR MATERIAL SUPPLIER FROM RESPONSIBILITY FOR ERRORS OR OMISSIONS FROM DRAWINGS AND SPECIFICATIONS
SELLEN CONSTRUCTION CO., INC.
GENERAL CONTRACTOR
By EB Date 9-10-86
Note Blockout revisions on submittal of 8-27-86

Do Not Manufacture
Without City of Seattle
Bldg. Dept. Approval

SEP 09 1986

△1	CHANGES PER CITY OF SEATTLE REQUIREMENTS & CONTR. INFO	8-25-86	DR
△	REVISIONS	DATE	CHECKED

JOB # 102-91 KEIRO NURSING HOME
SECTIONS.

SPAN-DECK
CENTRAL PRE-MIX
CONCRETE CO.
P.O. BOX 510 KENT, WA. 98031

DRAWN: KT
CHKD: [illegible]
DATE: 7-22-86
DRAWING NO.: 102-21
2/2

NOTE: If the microfilmed drawing is LESS clear than this notice, it is due to the quality of the original drawing.
24X

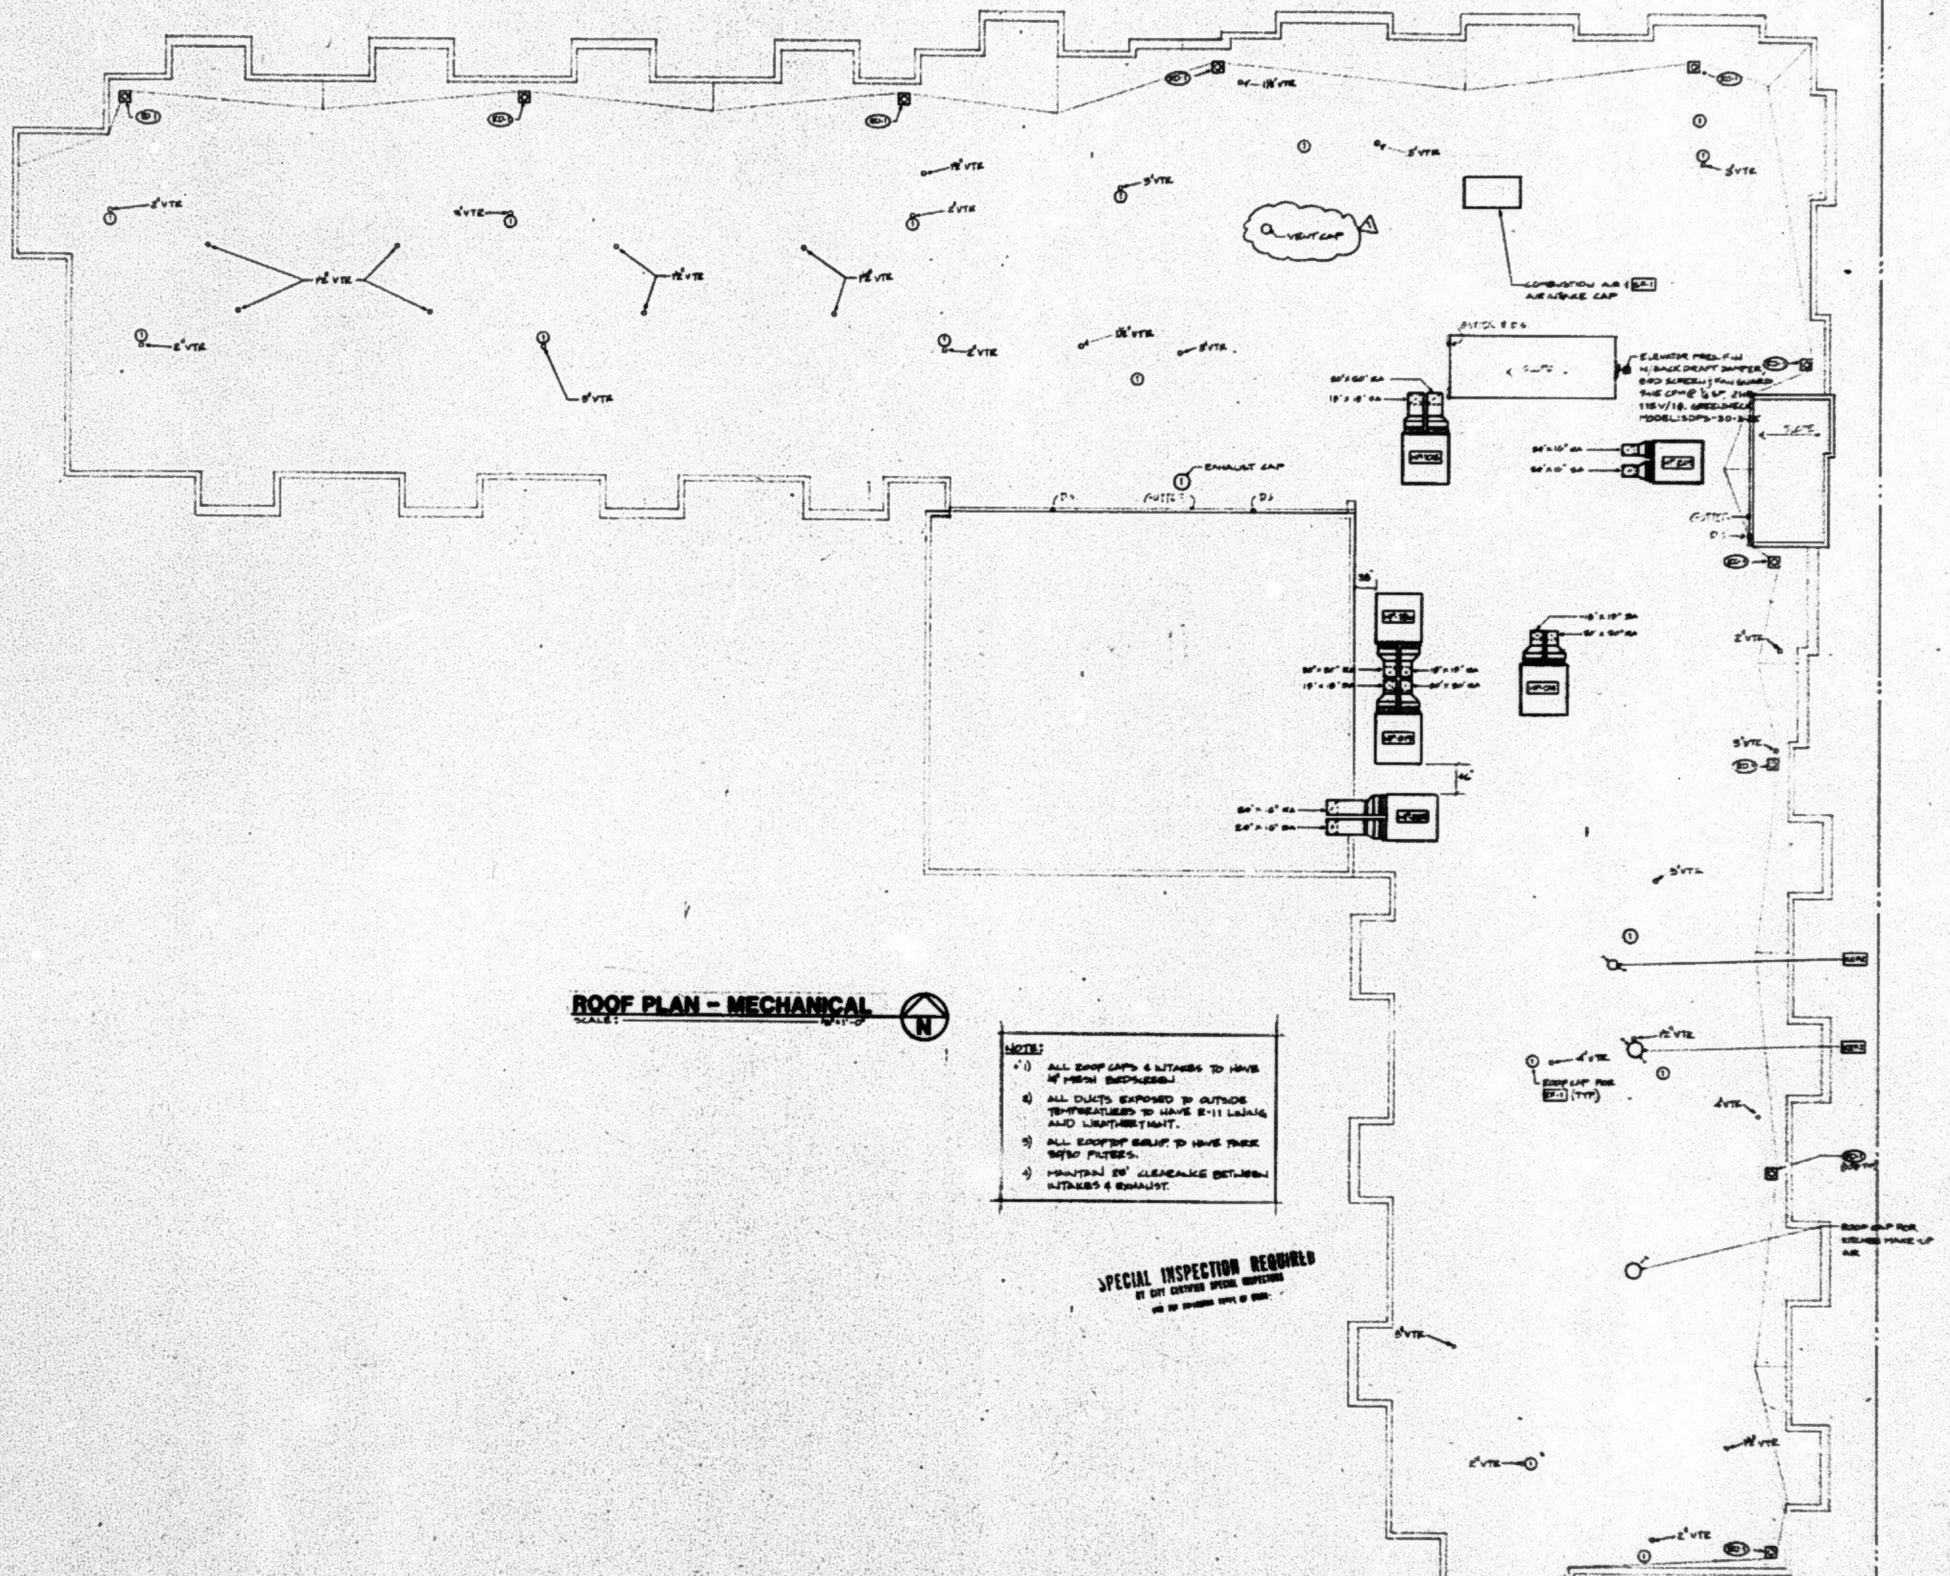
VENT CAP
COMBUSTION AIR & AIR INTAKE CAP
EXHAUST CAP
ROOF CAP FOR EF-1 (TYP)
ROOF CAP FOR KITCHEN MAKE-UP AIR
2" VTR
3" VTR
1½" VTR
N

ROOF PLAN - MECHANICAL

SCALE: 1/8"=1'-0"

NOTE:

1) ALL ROOF CAPS & INTAKES TO HAVE ½" MESH BIRDSCREEN.

2) ALL DUCTS EXPOSED TO OUTSIDE TEMPERATURES TO HAVE R-11 LINING AND WEATHERTIGHT.

3) ALL ROOFTOP EQUIP. TO HAVE FARR 30/30 FILTERS.

4) MAINTAIN 20' CLEARANCE BETWEEN INTAKES & EXHAUST.

SPECIAL INSPECTION REQUIRED
BY CITY CERTIFIED SPECIAL INSPECTORS

Project: SEATTLE KEIRO NURSING HOME
1601 E. Yesler Way
Seattle, Washington 98122
For: NIKKEI CONCERNS
1700 24th Ave So.
Seattle, Washington 98144-4697

Approval

Approved by	Date
Drawn by	Date

Revisions

No.	Description	Date
1	REVISION #1	[illegible]

Arai/Jackson Architects & Designers
[illegible]

M-15

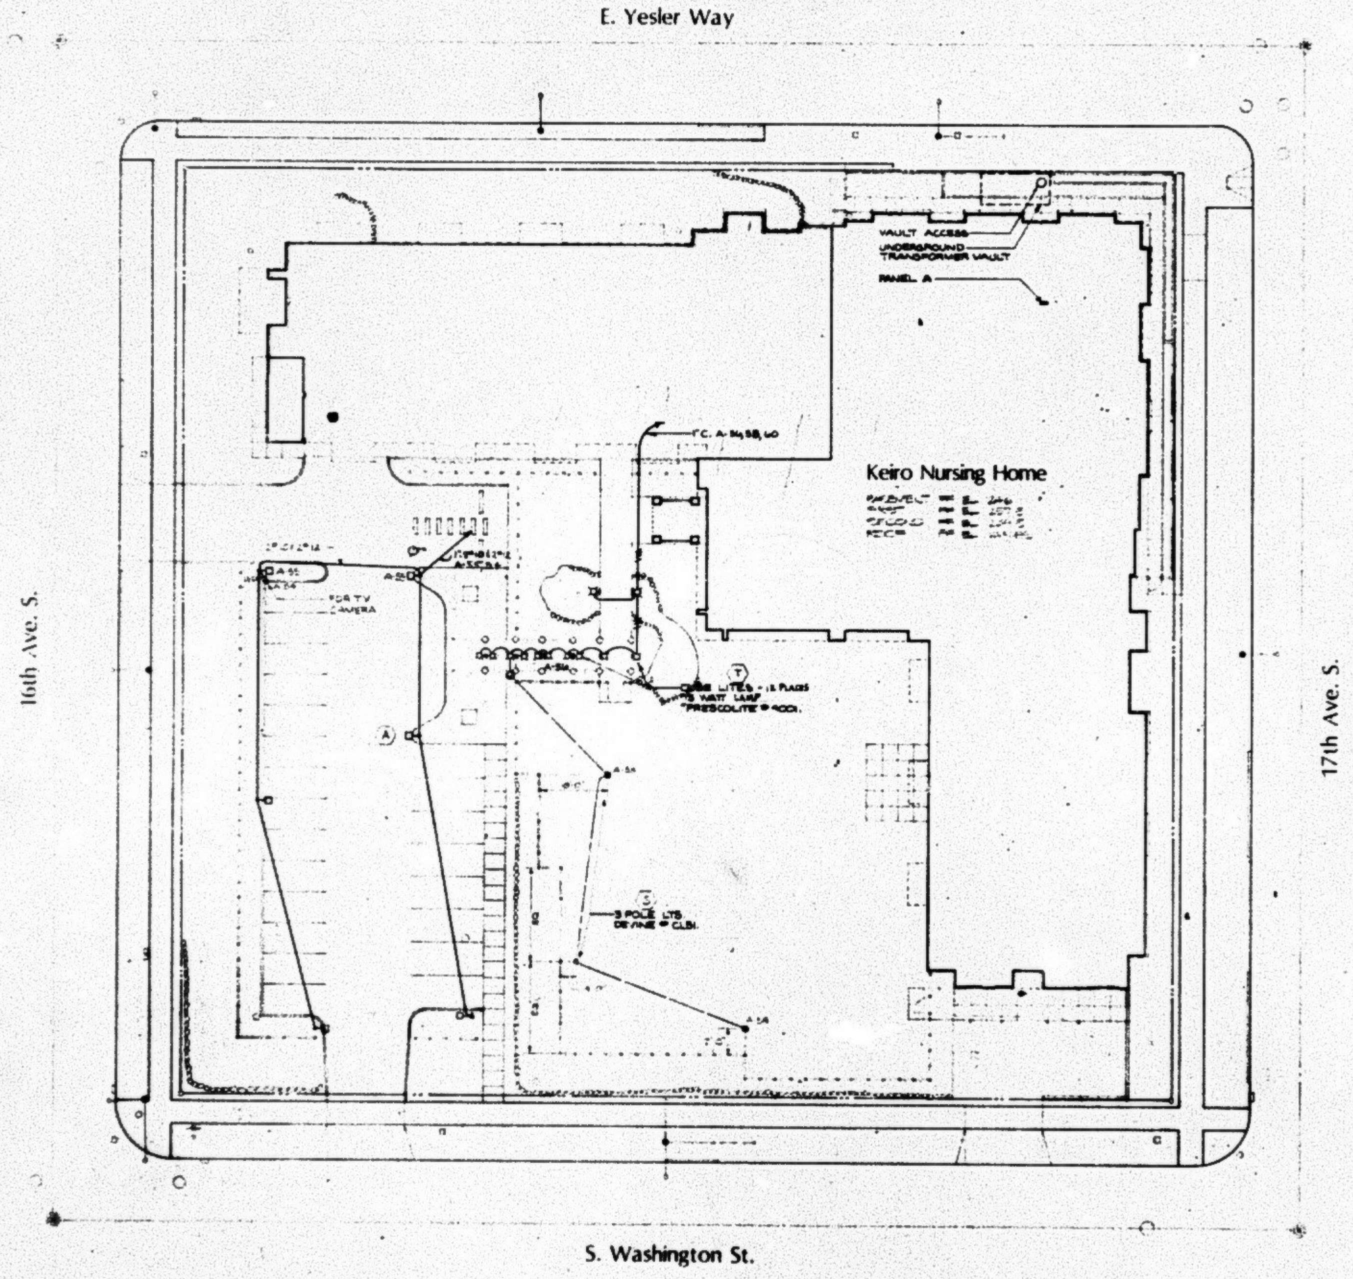
E. Yesler Way
16th Ave. S.
17th Ave. S.
S. Washington St.
VAULT ACCESS
UNDERGROUND TRANSFORMER VAULT
PANEL A
F.C. A-54,58,60
Keiro Nursing Home
FOR TV CAMERA
A-55
A-54
A-56
A-58
DOME LITES - 15 PLACES
75 WATT LAMP
"PRESCOLITE" # 4001.
3 POLE LTS
DEVINE # CL81.

SITE PLAN
SCALE 1/16"=1'-0"

LEGEND

- 2x4 FLUORESCENT FIXTURE - TYPE B OR A
- 2x2 FLUORESCENT FIXTURE - TYPE C
- 1x4, 2 LAMP FLUORESCENT FIXTURE - TYPE D
- WALL BRACKET FLUORESCENT FIXTURE - TYPE H OR K
- STEP LIGHT +18" FLUSH IN WALL - TYPE L
- ROUND RECESSED INCANDESCENT FIXTURE - TYPE F
- EXIT SIGN - ARROW WHERE SHOWN
- LIGHT OUTLET ON EMERGENCY POWER CIRCUIT
- TRACK LIGHTING/FIXTURE - TYPE P
- WALL SWITCH, SINGLE POLE
- WALL SWITCH, 3-WAY
- KEY SWITCH
- DUPLEX RECEPTACLE
- DUPLEX RECEPTACLE ABOVE COUNTER
- RECEPTACLE WITH GROUND FAULT-CIRCUIT INTERRUPTER
- JUNCTION BOX
- POWER OUTLET
- [illegible] OUTLET
- DISCONNECT SWITCH
- [illegible] OUTLET - 208-30A-1Ø
- PHONE OUTLET
- [illegible]
- CONDUIT CONCEALED IN CEILING OR WALLS
- EXPOSED CONDUIT OR SURFACE RACEWAY
- DIMMER SWITCH
- FLUORESCENT STRIP FIXTURE - TYPE E OR J
- POLE LIGHT FIXTURE - TYPE A
- POLE LIGHT - TYPE S
- INCANDESCENT LIGHTING FIXTURE - BRACKET MOUNT
- TELEVISION OUTLET, +12"
- FLUSH FLOOR BOX WITH TELEPHONE OUTLET
- FLUSH FLOOR BOX WITH RECEPTACLE
- FIXTURE TYPE
- 4-PLEX OUTLET - 40" FP

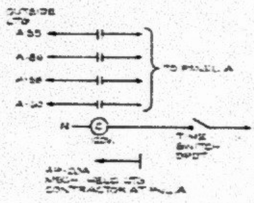
OUTSIDE LTG
A-55
A-54
A-56
A-58
TO PANEL A
N
C
CON.
TIME SWITCH DPDT
A-59

OUTSIDE LIGHT CONTROLS

Project: SEATTLE KEIRO NURSING HOME

For:

Approval

Approved by Date

Revisions

No. Description Date

Arai/Jackson Architects & Designers

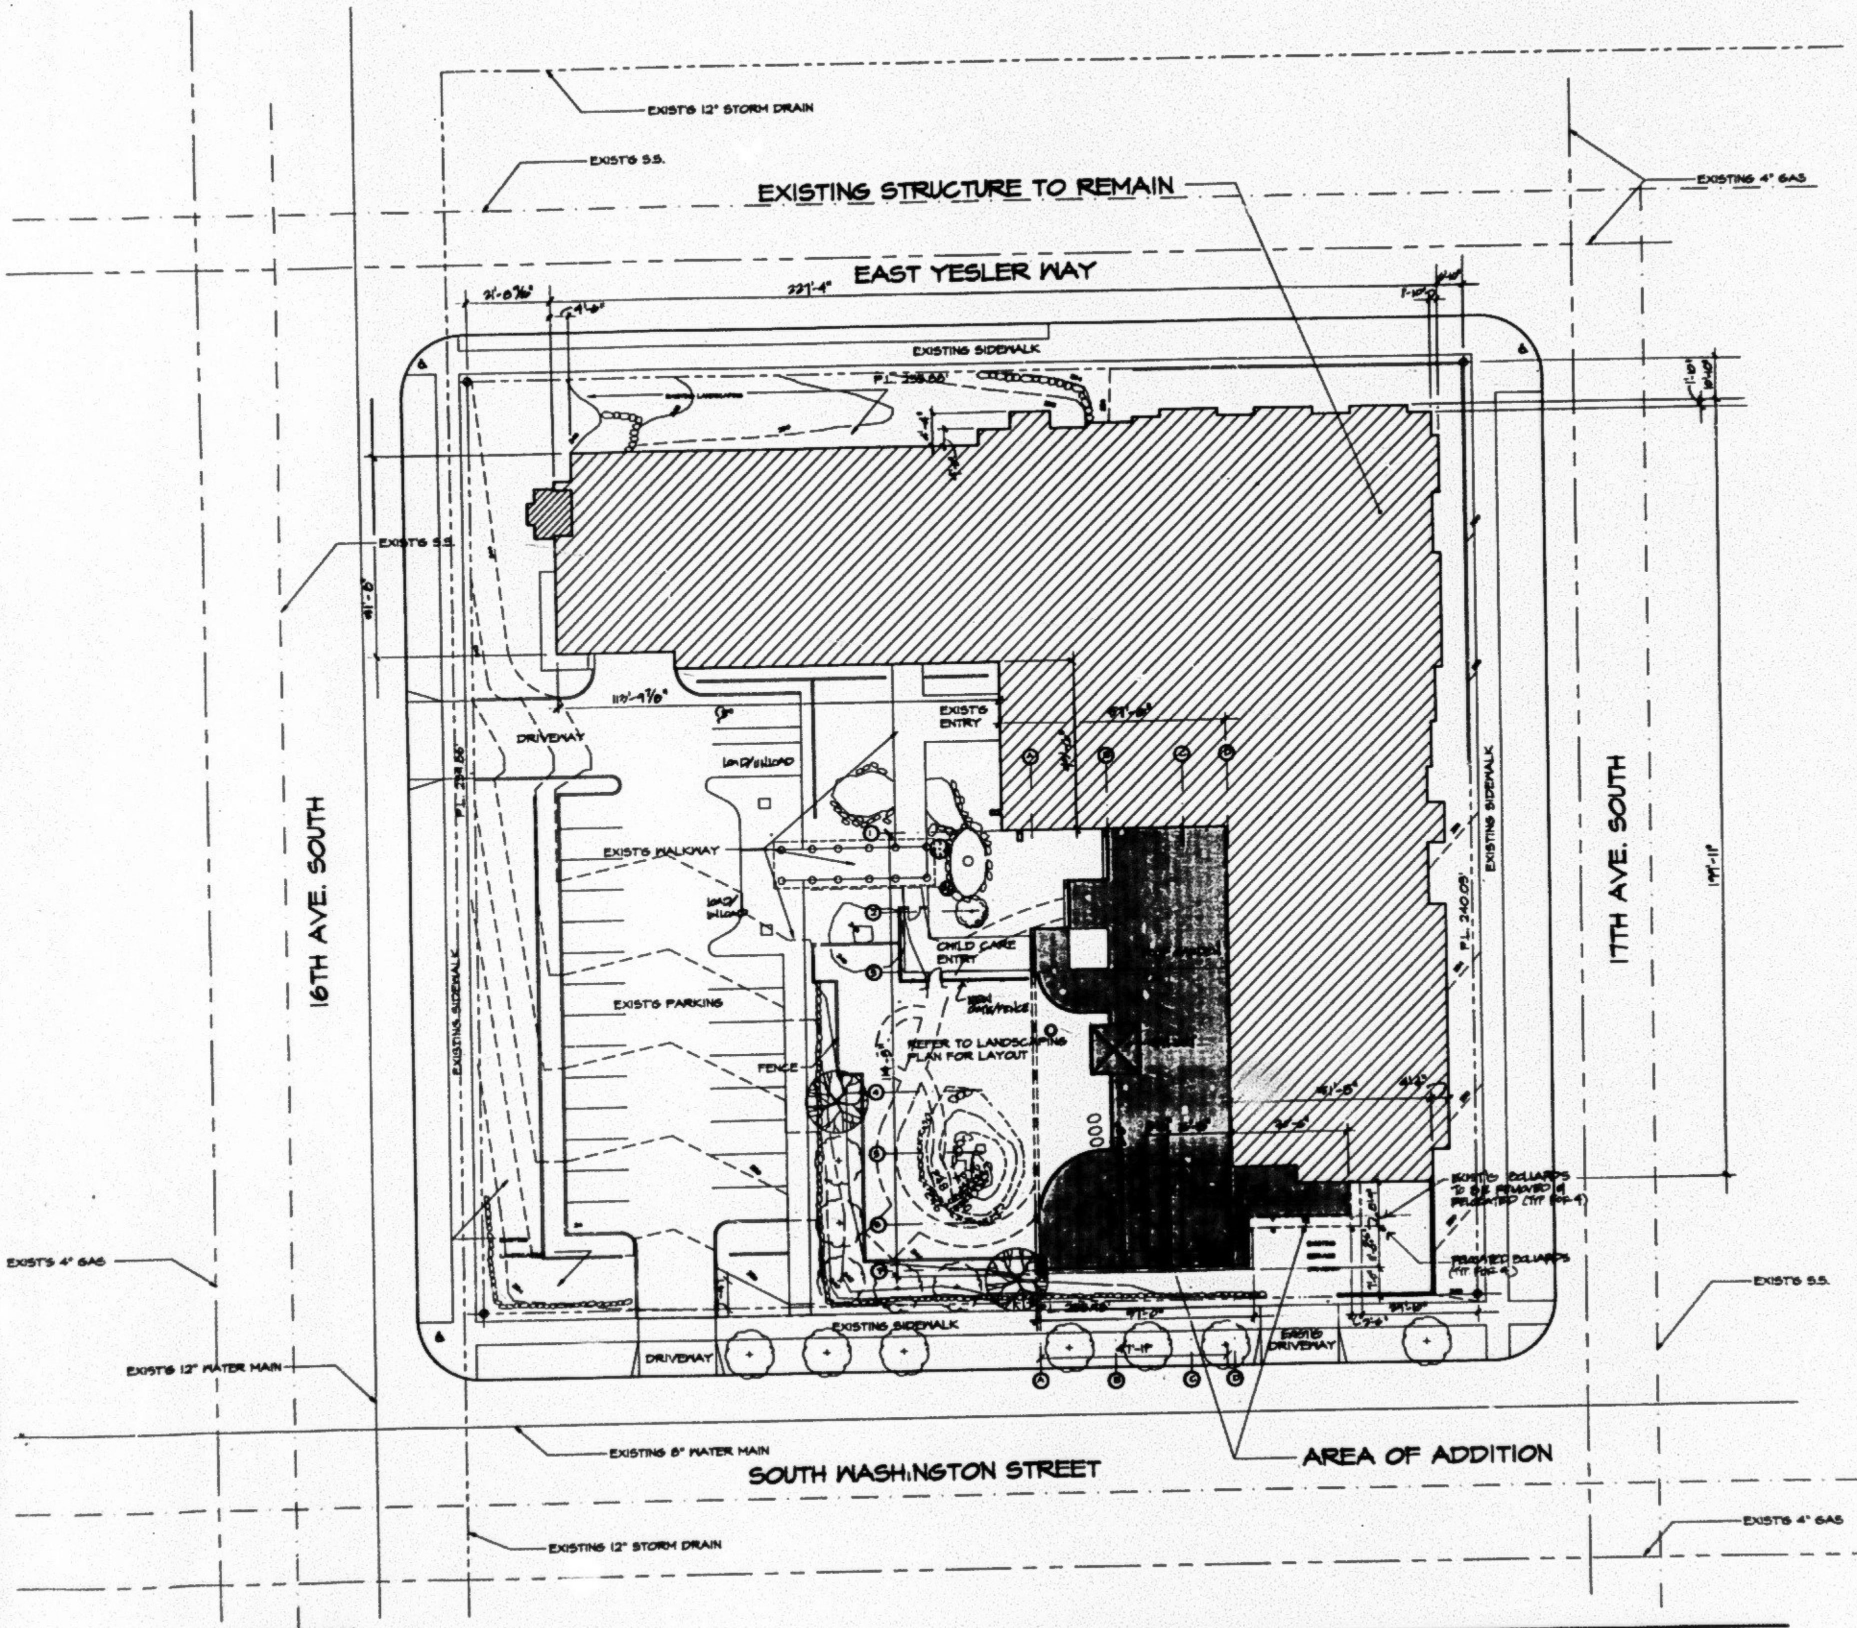
EXIST'G 12" STORM DRAIN
EXIST'G S.S.
EXISTING STRUCTURE TO REMAIN
EXISTING 4" GAS
EAST YESLER WAY
21'-0 3/16"
221'-4"
EXISTING SIDEWALK
P.L. 258.88'
EXIST'G S.S.
41'-6"
113'-9 7/8"
EXIST'G ENTRY
DRIVEWAY
LOAD/UNLOAD
P.L. 258.88'
16TH AVE. SOUTH
EXIST'G WALKWAY
LOAD/UNLOAD
CHILD CARE ENTRY
EXIST'G PARKING
EXISTING SIDEWALK
REFER TO LANDSCAPING PLAN FOR LAYOUT
FENCE
EXISTING SIDEWALK
P.L. 240.05'
17TH AVE. SOUTH
199'-11"
41'-5"
EXIST'G BOLLARDS TO BE REMOVED & RELOCATED (TYP. FOR 4)
RELOCATED BOLLARDS (TYP. FOR 4)
EXIST'G 4" GAS
EXIST'G S.S.
EXISTING SIDEWALK
DRIVEWAY
EXIST'G DRIVEWAY
91'-0"
47'-11"
A
B
C
D
EXIST'G 12" WATER MAIN
EXISTING 8" WATER MAIN
SOUTH WASHINGTON STREET
AREA OF ADDITION
EXISTING 12" STORM DRAIN
EXIST'G 4" GAS

SITE PLAN

KUBOTA KATO

Architect's Project No.

Drawn By: Date:

Checked By: Date:

No. Revision Date:

MJP 10-6-95

Project:

SEATTLE KEIRO
INTERGENERATIONAL
CHILD CARE ADDITION
& NURSING HOME
IMPROVEMENTS

1601 East Yesler Way
Seattle, WA 98122

Owner:

NIKKEI CONCERNS
1601 East Yesler Way
Seattle, WA 98122

If this sheet is less than 30" x 42" it is a reduction.

A1

Sheet of

RECEIVED
OCT 16 1995
Dept. of Construction & Land Use

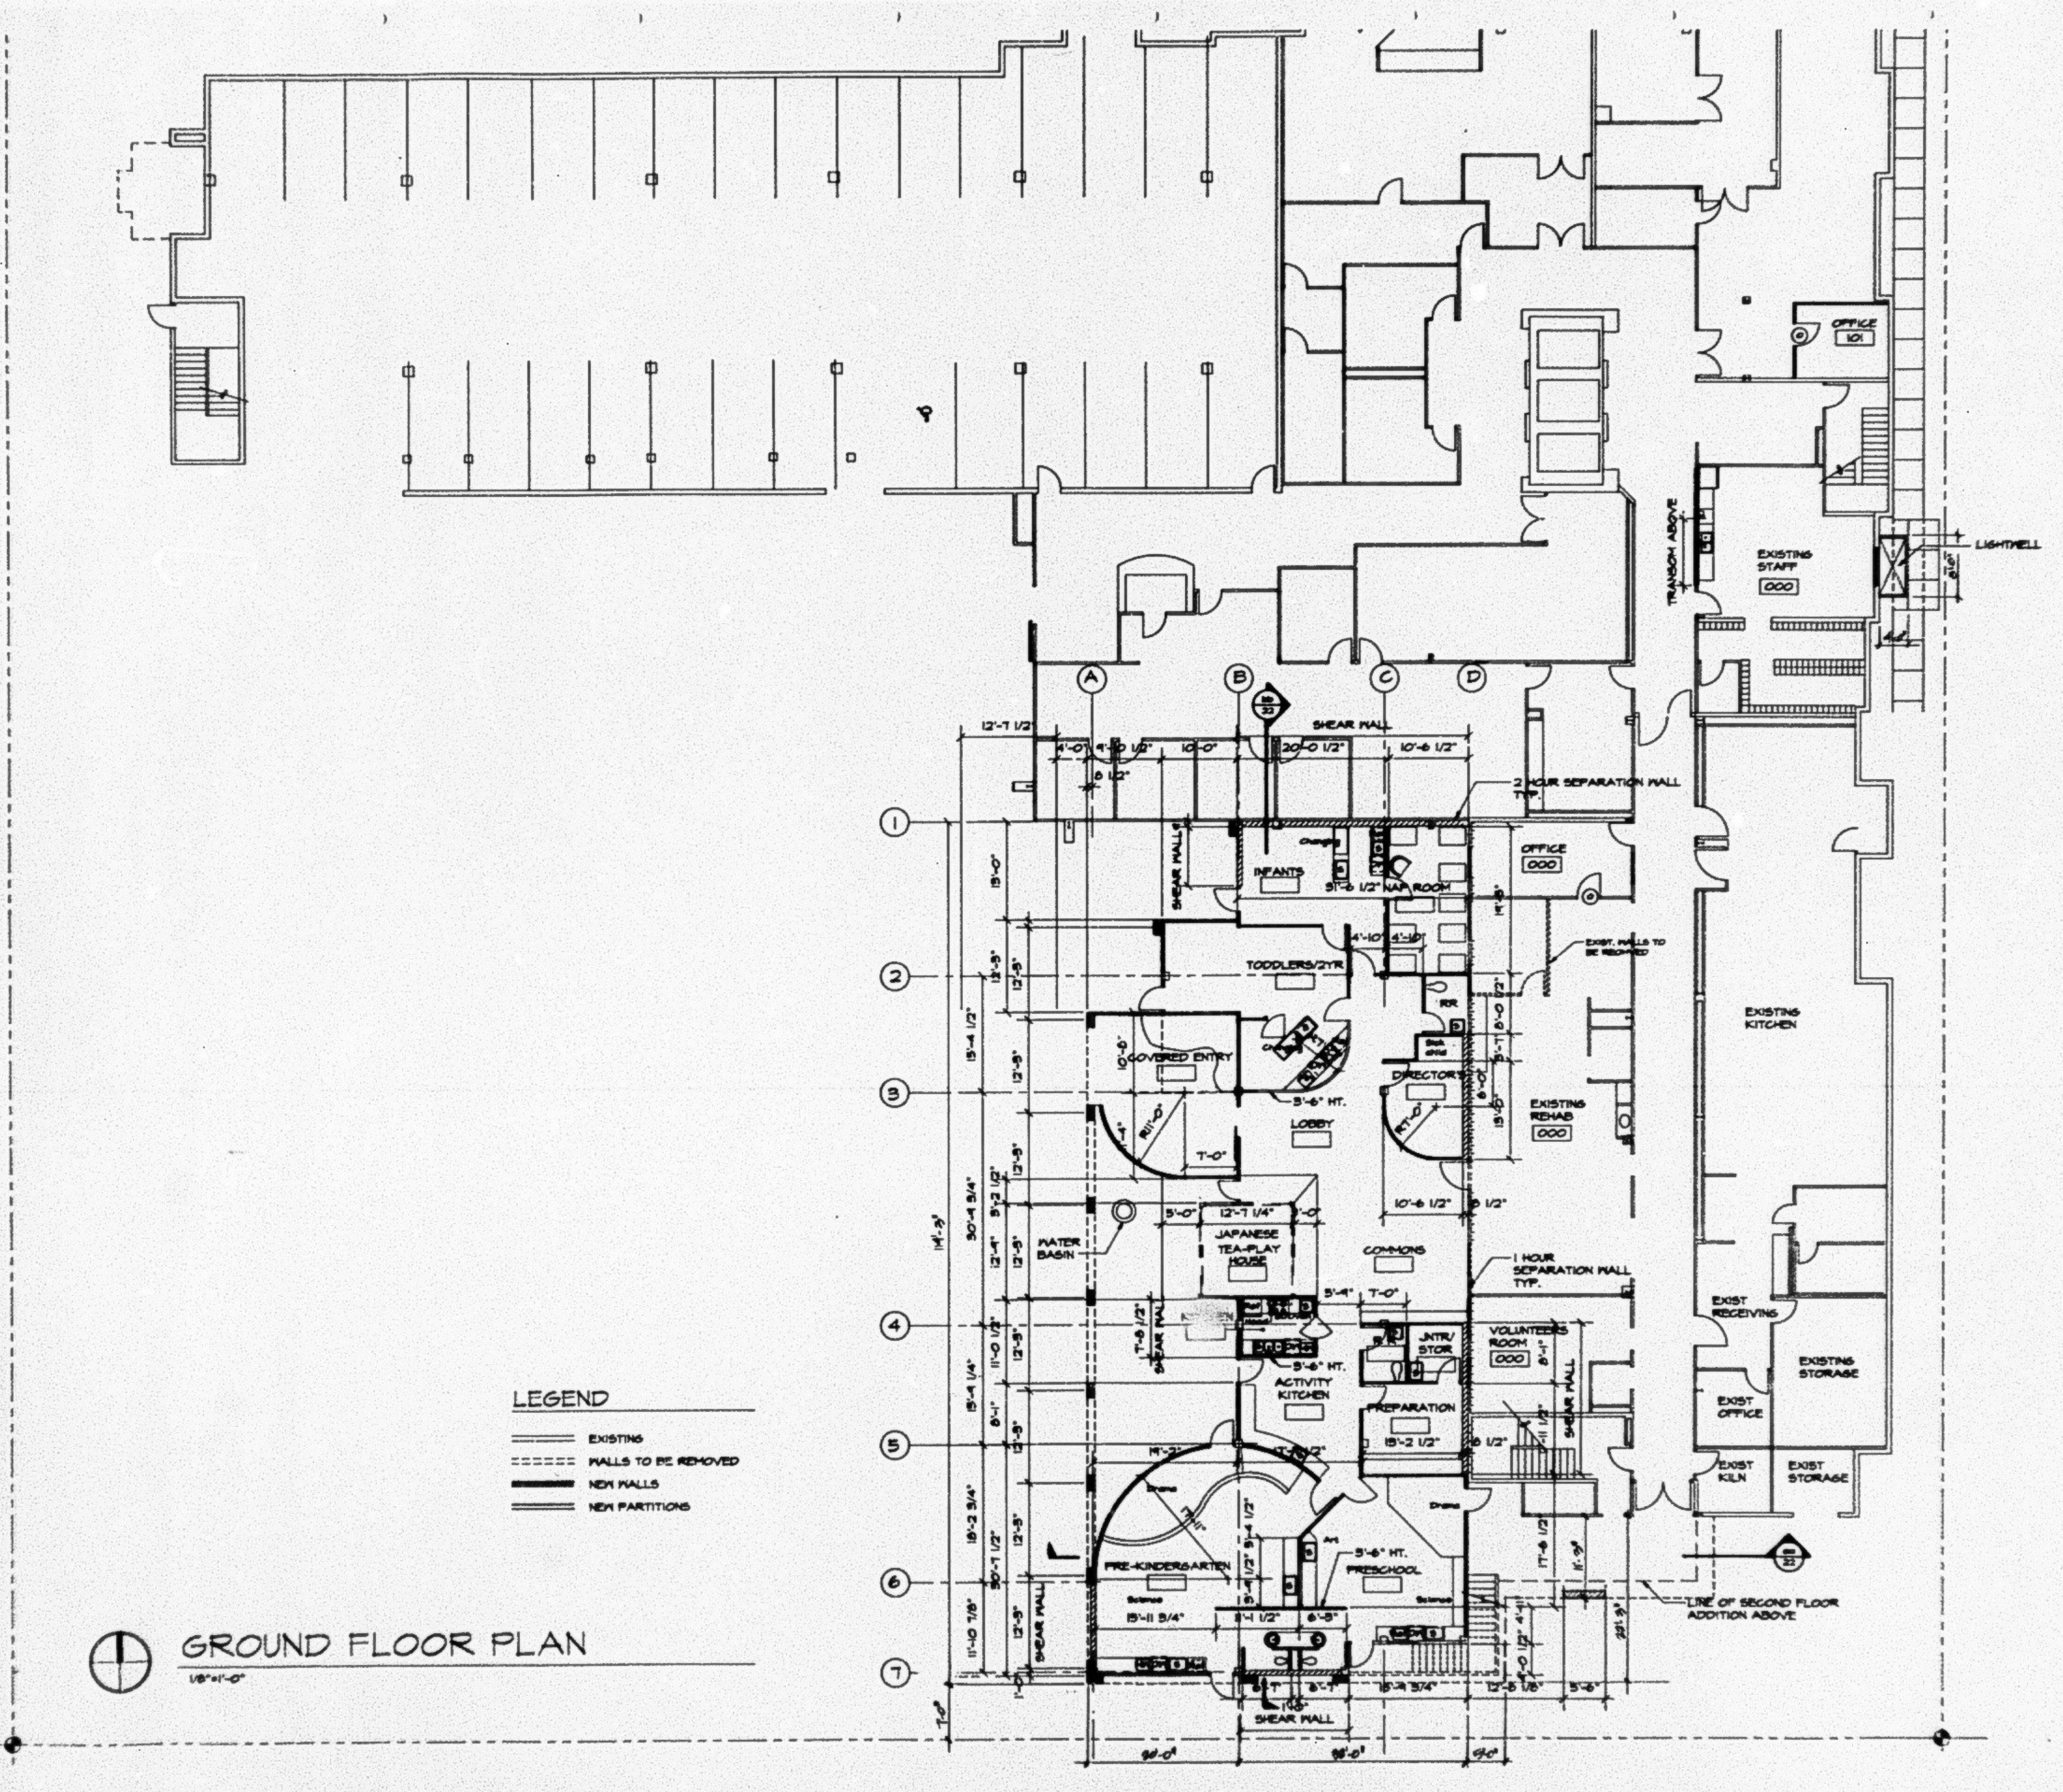
A
B
C
D
1
2
3
4
5
6
7
SHEAR WALL
12'-7 1/2"
4'-0"
4'-10 1/2"
10'-0"
20'-0 1/2"
10'-6 1/2"
6 1/2"
2 HOUR SEPARATION WALL TYP.
OFFICE 101
TRANSOM ABOVE
EXISTING STAFF 000
LIGHTWELL
INFANTS
Changing
31'-6 1/2" NAP ROOM
OFFICE 000
4'-10"
4'-10"
TODDLERS/2YR
EXIST. WALLS TO BE REMOVED
RR
Sick child
COVERED ENTRY
10'-0"
3'-6" HT.
DIRECTOR'S
EXISTING REHAB 000
EXISTING KITCHEN
R11'-0"
R7'-0"
7'-0"
LOBBY
10'-6 1/2"
6 1/2"
5'-0"
12'-7 1/4"
JAPANESE TEA-PLAY HOUSE
WATER BASIN
COMMONS
1 HOUR SEPARATION WALL TYP.
5'-4"
7'-0"
KITCHEN
7'-6 1/2"
3'-6" HT.
ACTIVITY KITCHEN
JNTR/ STOR
VOLUNTEERS ROOM 000
8'-1"
PREPARATION
13'-2 1/2"
6 1/2"
EXIST RECEIVING
EXISTING STORAGE
EXIST OFFICE
EXIST KILN
EXIST STORAGE
14'-2"
7'-10 1/2"
Drama
Art
3'-6" HT.
PRE-KINDERGARTEN
PRESCHOOL
Science
Science
15'-11 3/4"
8'-1 1/2"
6'-5"
LINE OF SECOND FLOOR ADDITION ABOVE
SHEAR WALL
13'-0"
12'-5"
15'-4 1/2"
30'-4 3/4"
5'-2 1/2"
12'-4"
11'-0 1/2"
15'-4 1/4"
8'-1"
18'-2 3/4"
30'-7 1/2"
11'-10 7/8"
141'-3"
7'-0"
6'-1"
6'-7"
18'-9 3/4"
12'-5 1/8"
5'-6"
96'-0"
98'-0"
54'-0"

LEGEND

EXISTING
WALLS TO BE REMOVED
NEW WALLS
NEW PARTITIONS

GROUND FLOOR PLAN

1/8"=1'-0"

Architect's Project No:

Drawn By: Date:

Checked By: Date:

No. Revision Date:

MJP 10-16-95

Project:

SEATTLE KEIRO
INTERGENERATIONAL
CHILD CARE ADDITION
& NURSING HOME
IMPROVEMENTS

1601 East Yesler Way
Seattle, WA 98122

Owner:

NIKKEI CONCERNS
1601 East Yesler Way
Seattle, WA 98122

A2

Sheet of

RECEIVED
OCT 16 1995
Dept. of Construction & Land Use